


T.18S.R.2W.W.M.

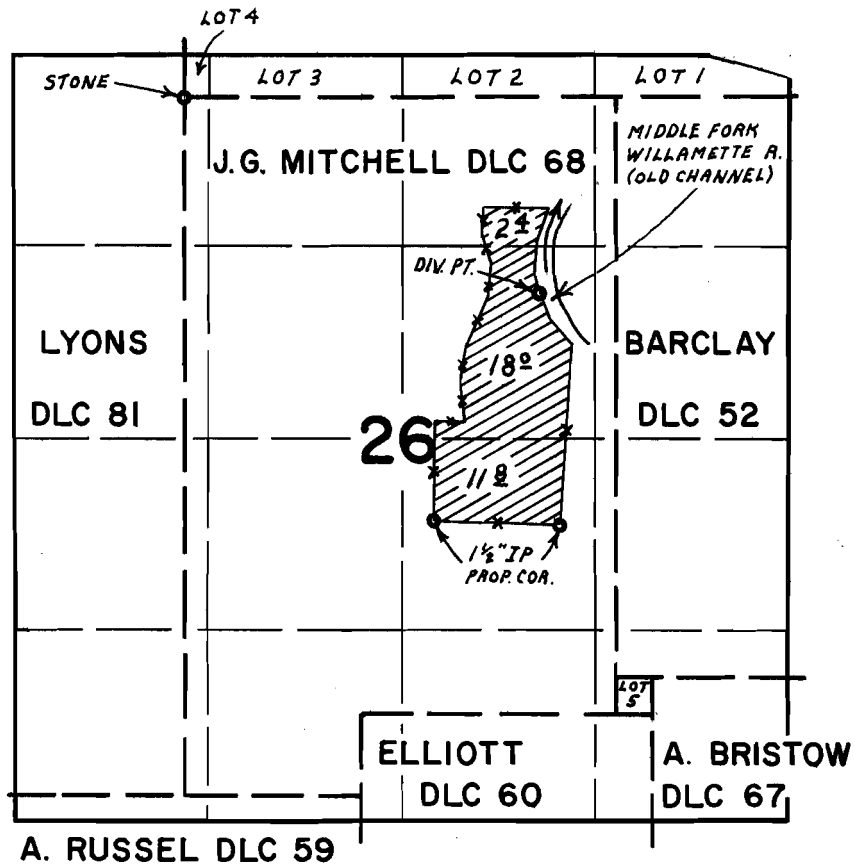

DIV. PT. LOC. 1340'S. & 2420'E. FROM NW COR. J.G. MITCHELL DLC 68

FINAL PROOF SURVEY

UNDER

Application No. 44677 Permit No. 33119

IN NAME OF

L.W. TENNIS

Surveyed OCT. 12 19 70, by G. BACA