


T. 11 S. R. 4 W. W.M.

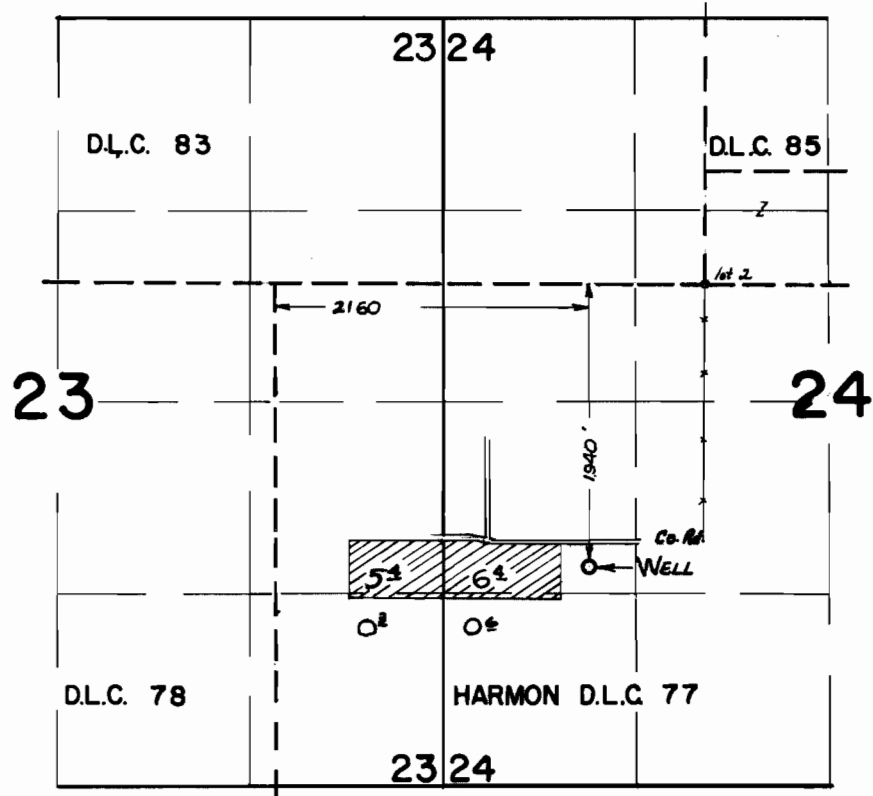

FINAL PROOF SURVEY UNDER

Application No. G 3570 Permit No. G 3364
IN NAME OF

RAY & VELMA MADDY

Surveyed 1 APRIL 1970, by DR. BUELL