


T. 11 S. R. 3 W. W.M.

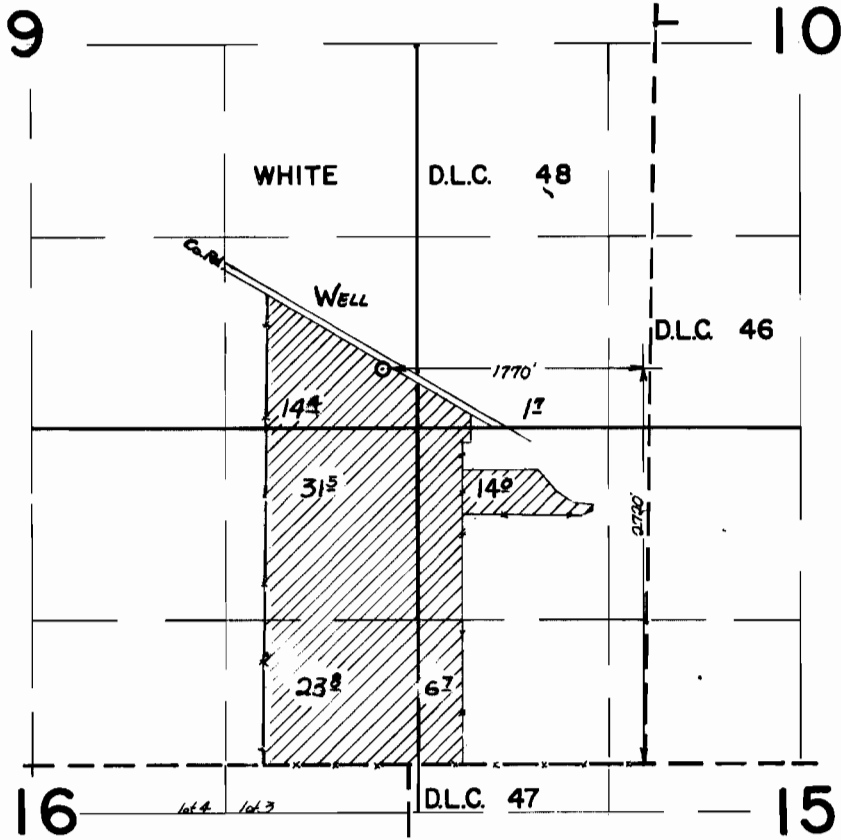

FINAL PROOF SURVEY UNDER

Application No. G 3651 Permit No. G 3430
IN NAME OF

ALVA & ANNA MITCHELL

Surveyed 10 APRIL 1970, by D.R. BUELL