


T. 11 S. R. 2 W. W.M.

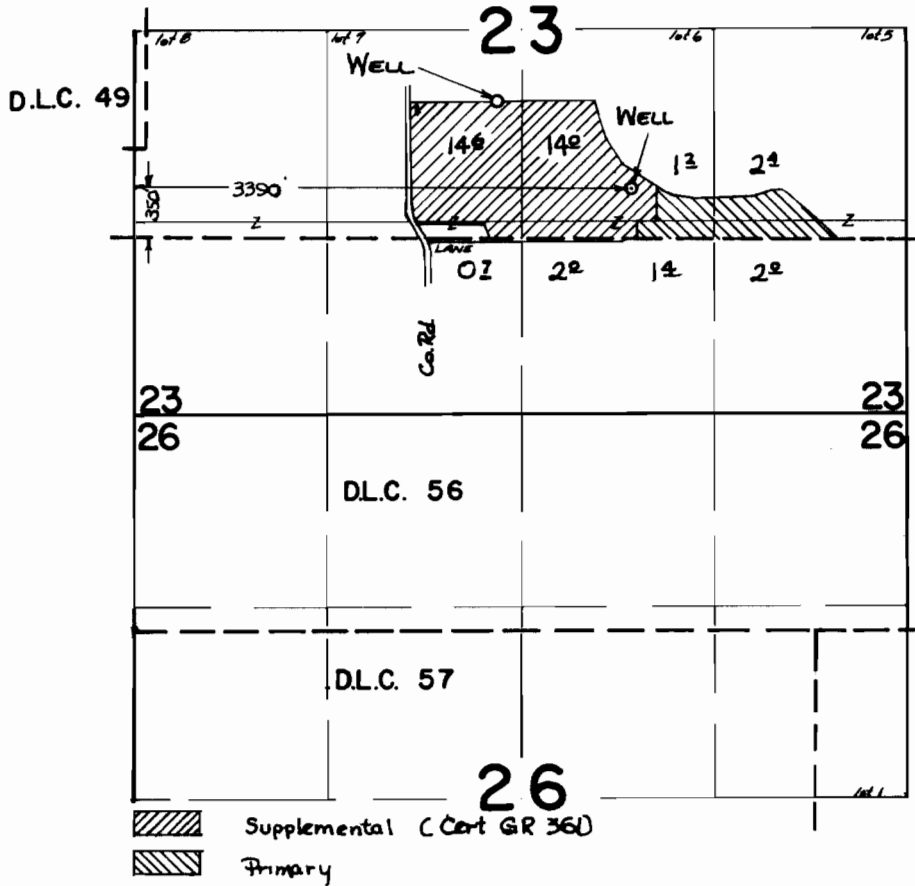

FINAL PROOF SURVEY UNDER

Application No. G 3747 Permit No. G 3539
IN NAME OF

LEONARD C. & RUTH L. DONOVAN

Surveyed 21 APRIL 1970, by D. R. BUELL