


T.10S.R.2W.W.M.

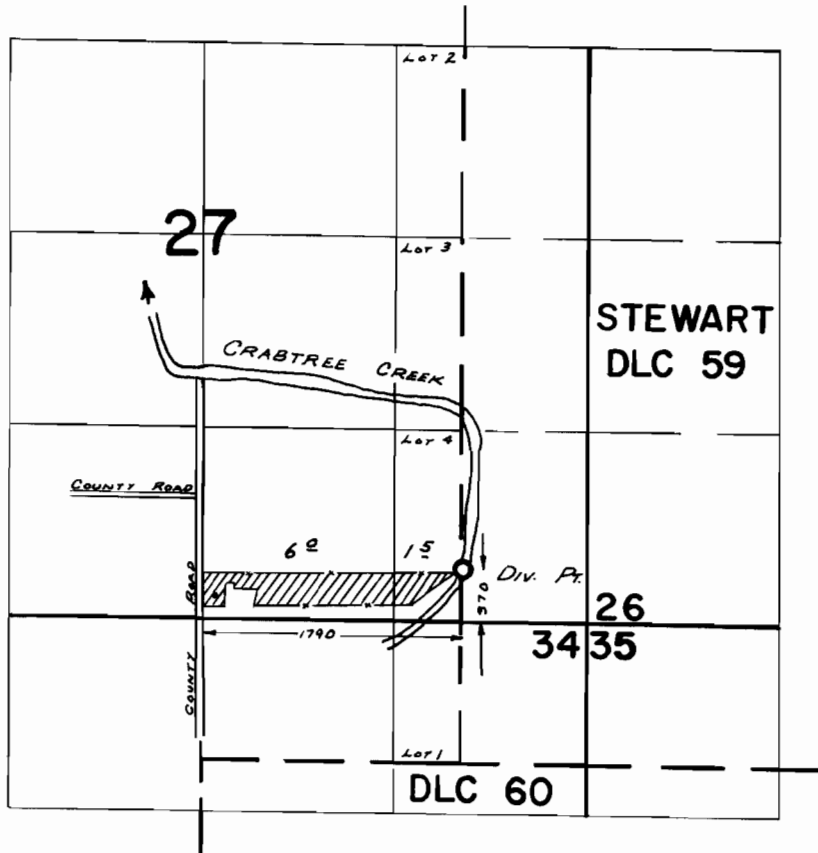

FINAL PROOF SURVEY
UNDER

Application No. 42161 Permit No. 31237
IN NAME OF

PAUL & LANELL SCARBOROUGH

Surveyed MARCH 18, 1969, by W. RUPPERT