


T.12S. R.4W. W.M.

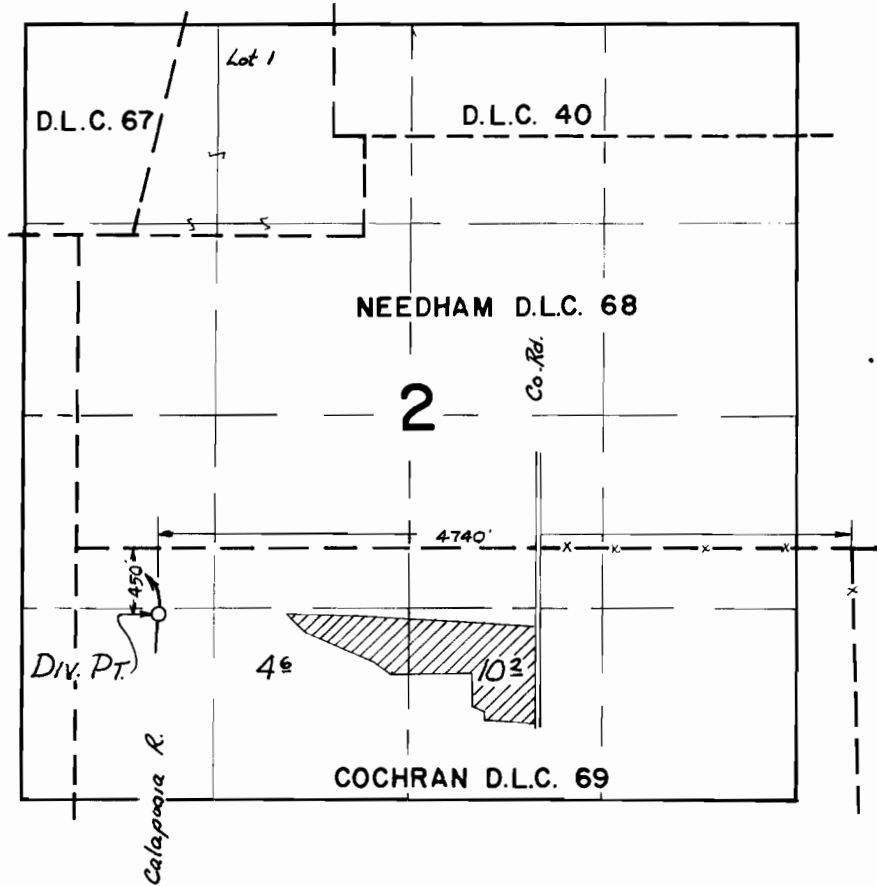

FINAL PROOF SURVEY UNDER

Application No. 41931 Permit No. 31409
IN NAME OF

GEORGE F. & JUDY LYNN HINCK

Surveyed 9 JULY 1970, by R. G. MUCKEN