


T.I.S. R.I.W.W.M.

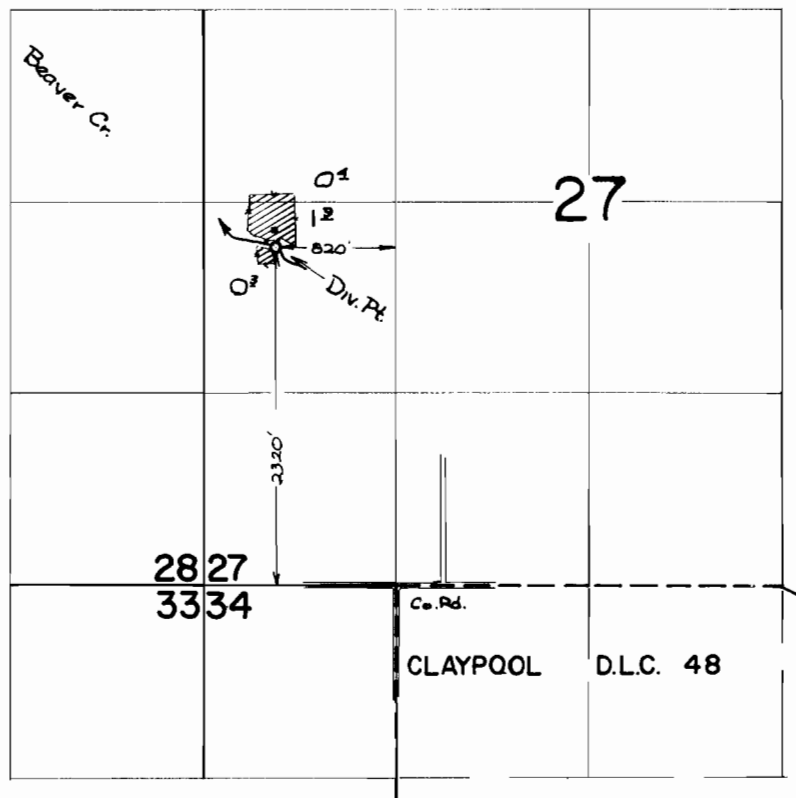

FINAL PROOF SURVEY
UNDER

Application No. 42341 Permit No. 31654
IN NAME OF

LUDWIG J. & GERTRUDE A. SUING

Surveyed 30 JULY 1970, by D. R. BUELL