


T. 11 S. R. 1 W. W. M.

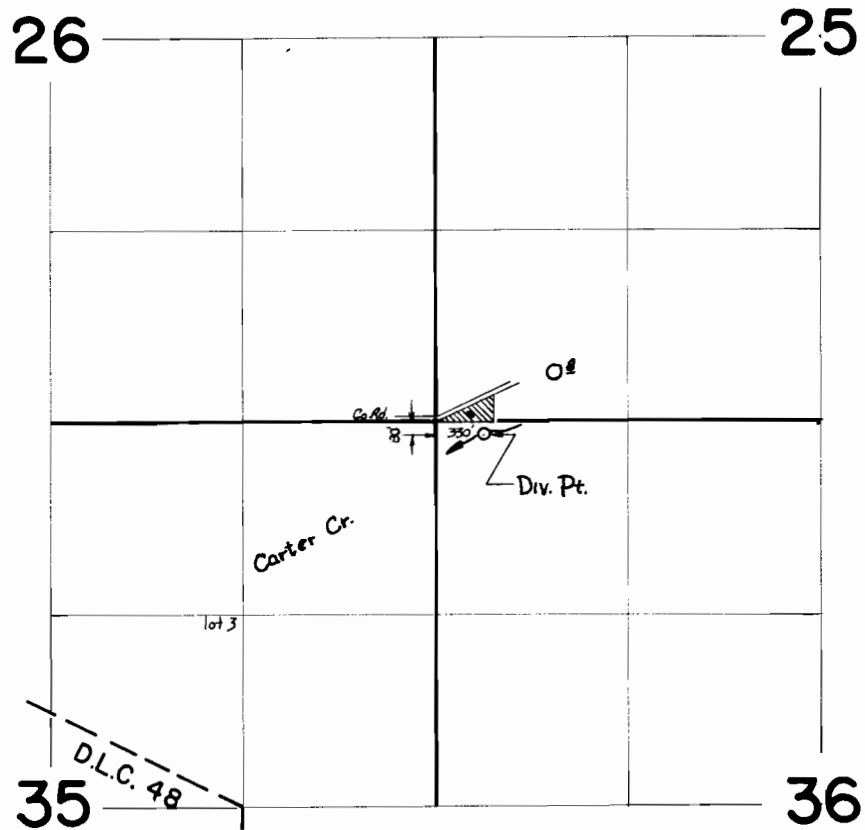

FINAL PROOF SURVEY
UNDER

Application No. 44319 Permit No. 33096
IN NAME OF

CHARLEY & ANN CLARISE RAY

Surveyed 31 MAR 1970, by D. R. BUELL