


T. I I S. R. I E. W. M.

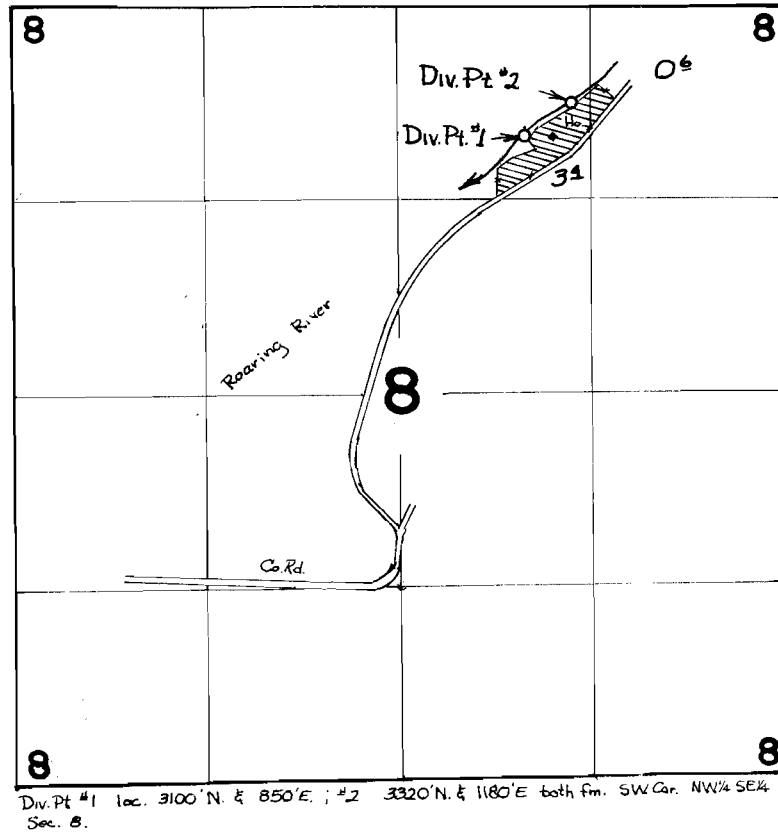


44334

33107

CLARENCE W. LYON

Surveyed 8 JULY 70 by D.R. BUELL