


T. 13 S. R. 1 W. W.M.

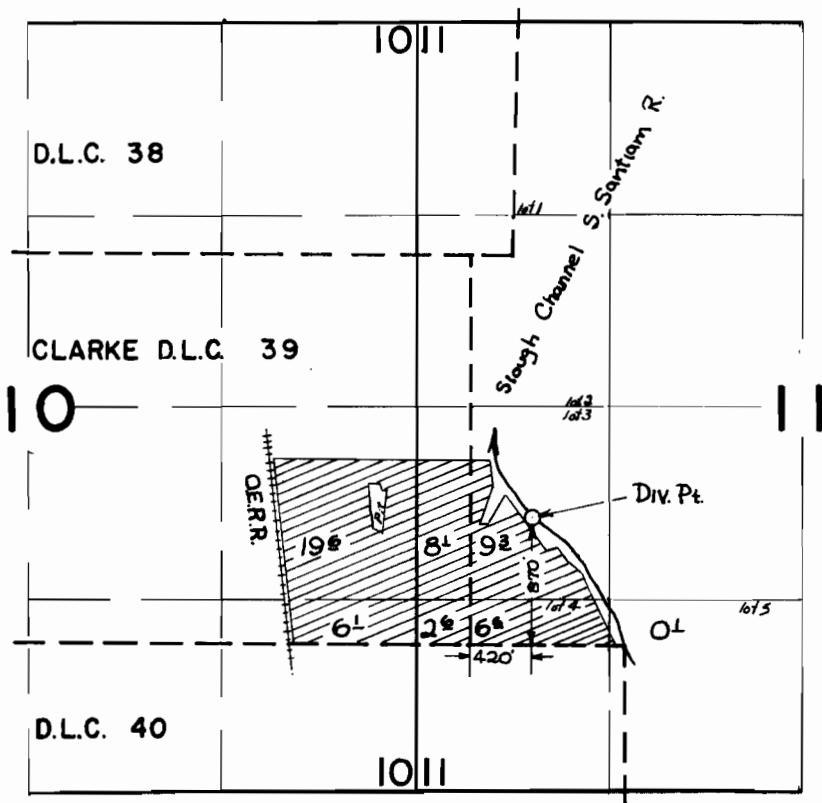

**FINAL PROOF SURVEY**  
UNDER

Application No. 45300 ... Permit No. 33823 ...  
IN NAME OF

**WALTER L. or IONE NELSON**

Surveyed 20 APRIL 1970, by D. R. BUELL