T. 13 & 14 S. R. 40 E. W.M.

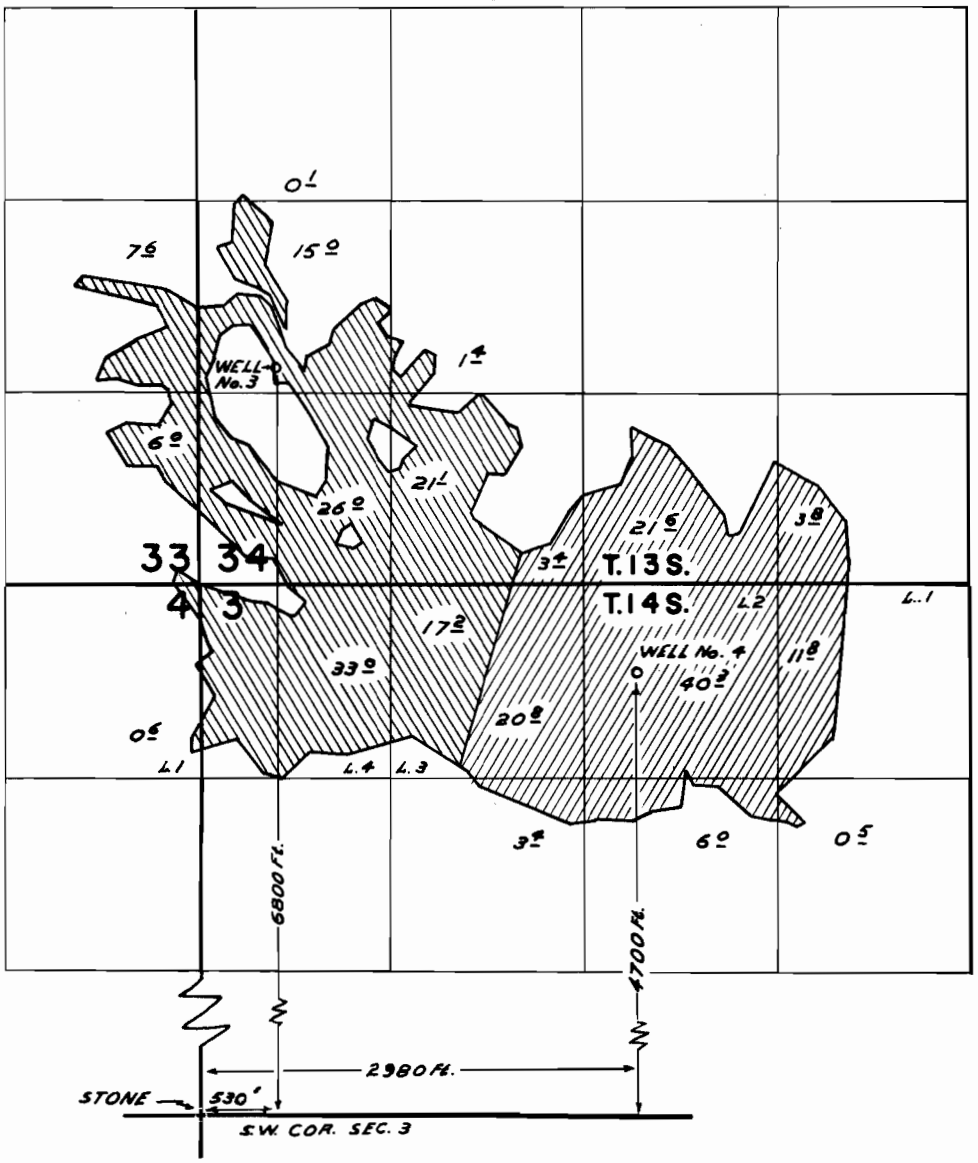

FINAL PROOF SURVEY

UNDER

Application No. G-3341 G-2420 Permit No. G-3137 G-2220

IN NAME OF

OTTO BRONSON

Surveyed OCT. 14 1965, by L. COLEBANK

Inspected Oct. 16 1970, by F. Elfering

1965-U