


T.14 S.R.40 E.W.M.

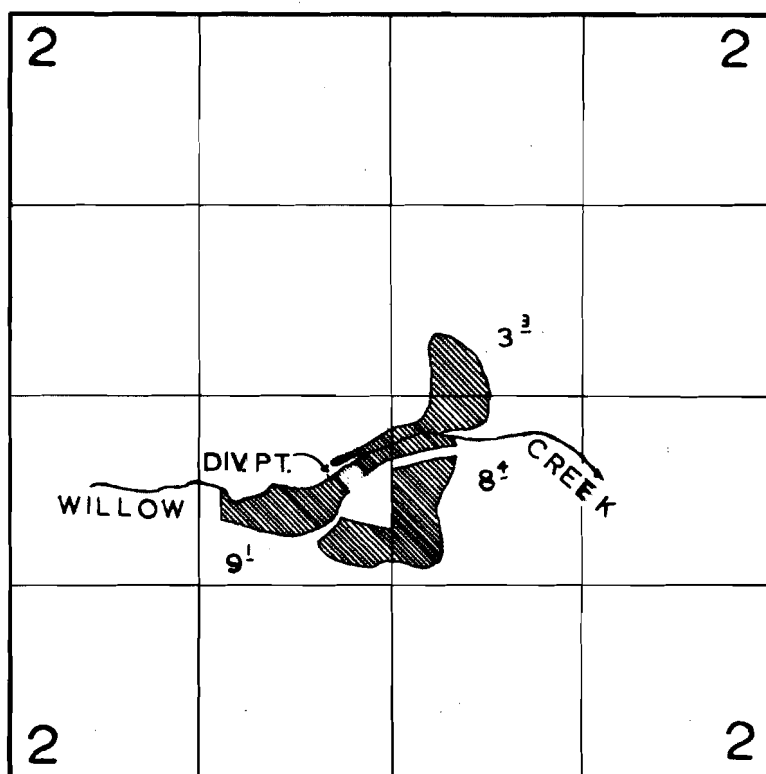

DIV. PT. IS 2200' E. & 2070' N. FROM SW. COR. SEC. 2

FINAL PROOF SURVEY
UNDER

Application No. 41797... Permit No. 31288...
IN NAME OF

LOUISE BRONSON

Surveyed OCT. 16, 1970, by F. E. E. RING.