


T.14 S. R. 40 E. W.M.

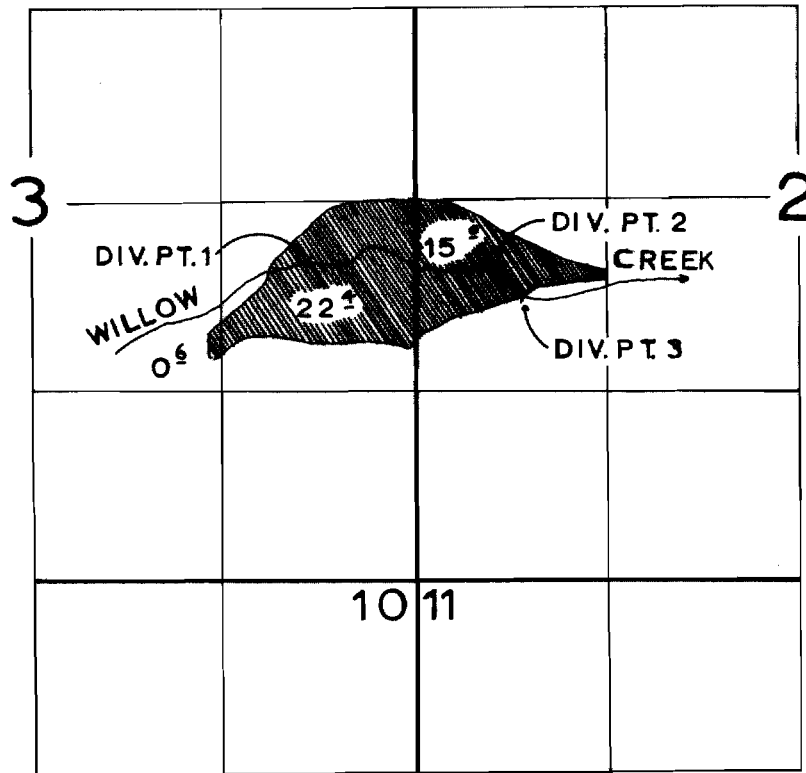

DIV. PT. 1 IS 725' W. & 2180' N. FROM SE. COR. SEC. 3

DIV. PT. 2 IS 560' E. & 2130' N. FROM SW. COR. SEC. 2

DIV. PT. 3 IS 740' E. & 1950' N. FROM SW. COR. SEC. 2

**FINAL PROOF SURVEY**  
UNDER

Application No. 41799... Permit No. 31289...  
IN NAME OF

THOMAS J. BRONSON

Surveyed OCT. 16, 1970, by F. E. L. F. RING...