


T.8S.R.3W.W.M.

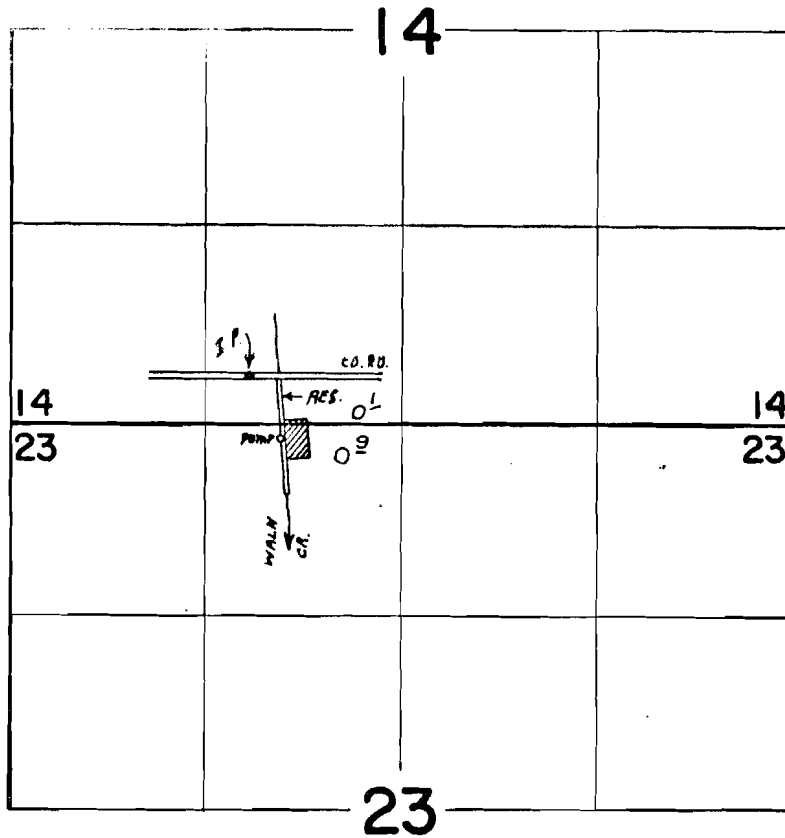

DIV. PT. LOC. 180'S. & 1870'E. FROM NW COR. SEC. 23

FINAL PROOF SURVEY UNDER

R-41205 R-4607
Application No. ... 41206 Permit No. ... 30622
IN NAME OF

STEVE BROOKS

Surveyed SEPT. 21, 1970, by A. E. GOULD