T. 7 S. R. 5 W. W.M.

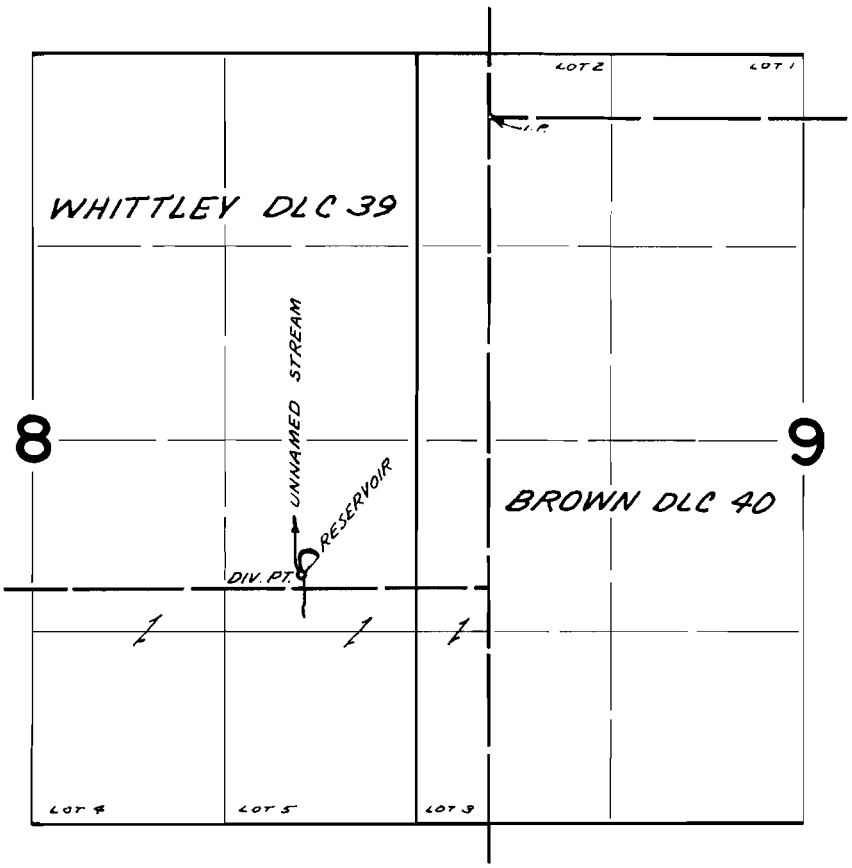

FINAL PROOF SURVEY
UNDER

Application No. R-42089 Permit No. R-4811
IN NAME OF

KERMIT MELVIN COURTER

Surveyed APR. 22 1969, by D. BUELL

1969-A