


T.29S. R.4W. W.M.

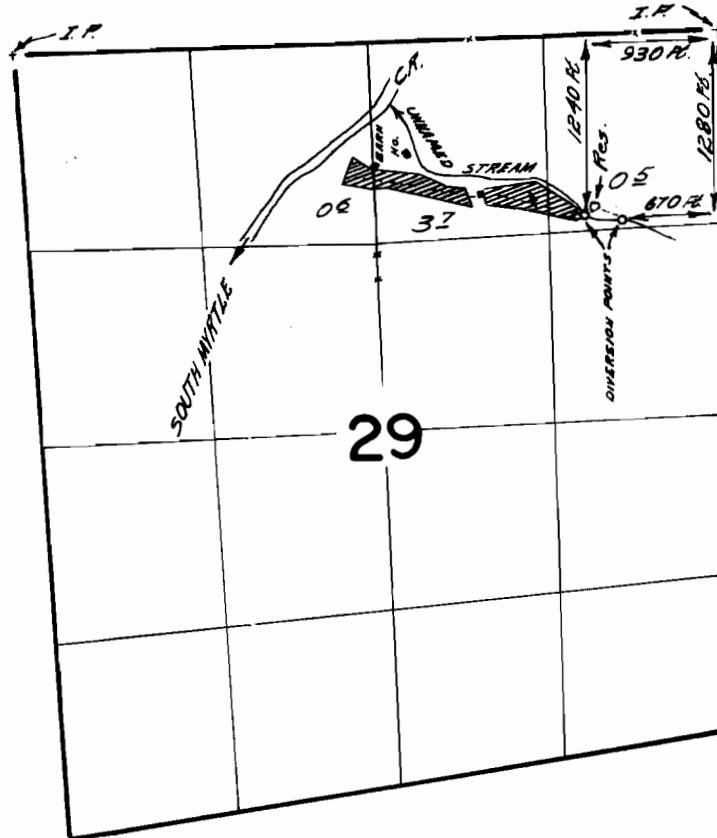

FINAL PROOF SURVEY
UNDER

Application No. 22804 Permit No. 17951
IN NAME OF

WILLIAM E. WILLIAMS

Surveyed July 22, 1949, by H.L. Coffman
June 27, 1968 by W.D. Ruppert