


U-744

26901  
37771 PR

# T.40 S.R.8E.W.M.

Klamath River weels

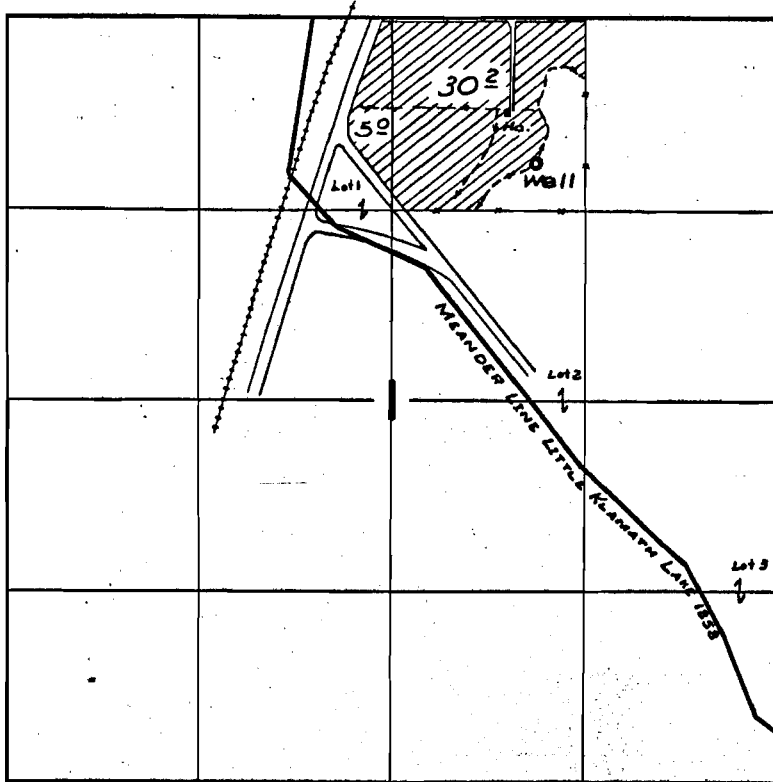

## FINAL PROOF SURVEY

UNDER

Application No. U-848 Permit No. U-744

IN NAME OF

CAROL E. HORSLEY

Surveyed 28 Oct 1959, by M. B. Bick