


T. 7 & 8 S. R. 38 E. W. M.

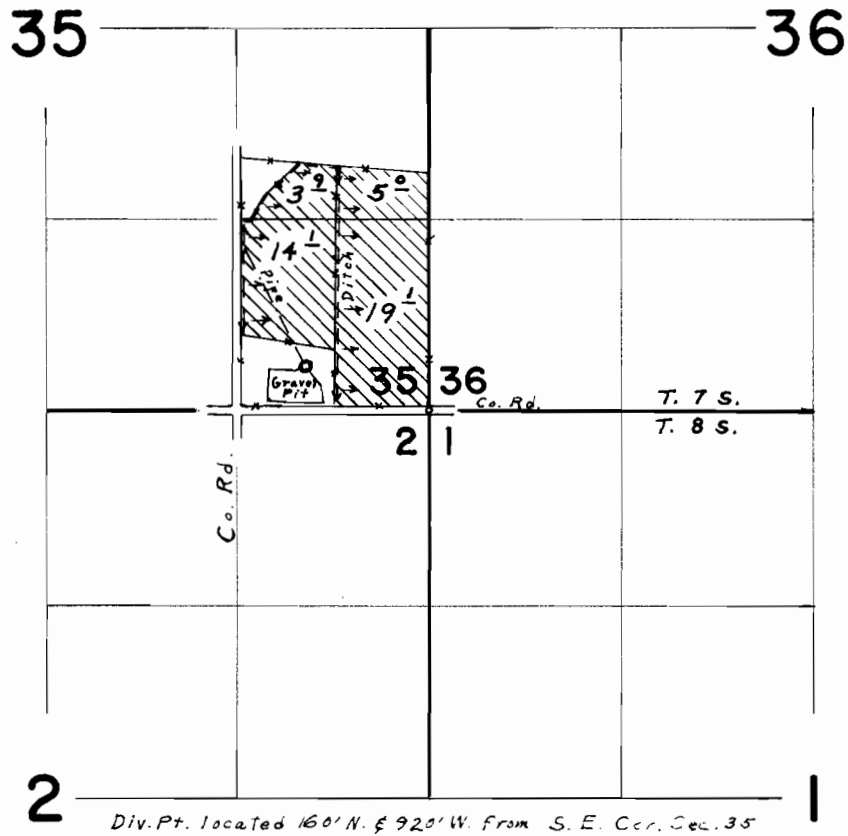

MINERAL PROOF SURVEY

WATER

Map No. G-2624 and G-2453

Sheet No. 1

LIONEL D. SHURTLEFF

Surveyed May 20, 1970 by L. E. Gould