


# T.7S.R.45E.W.M.

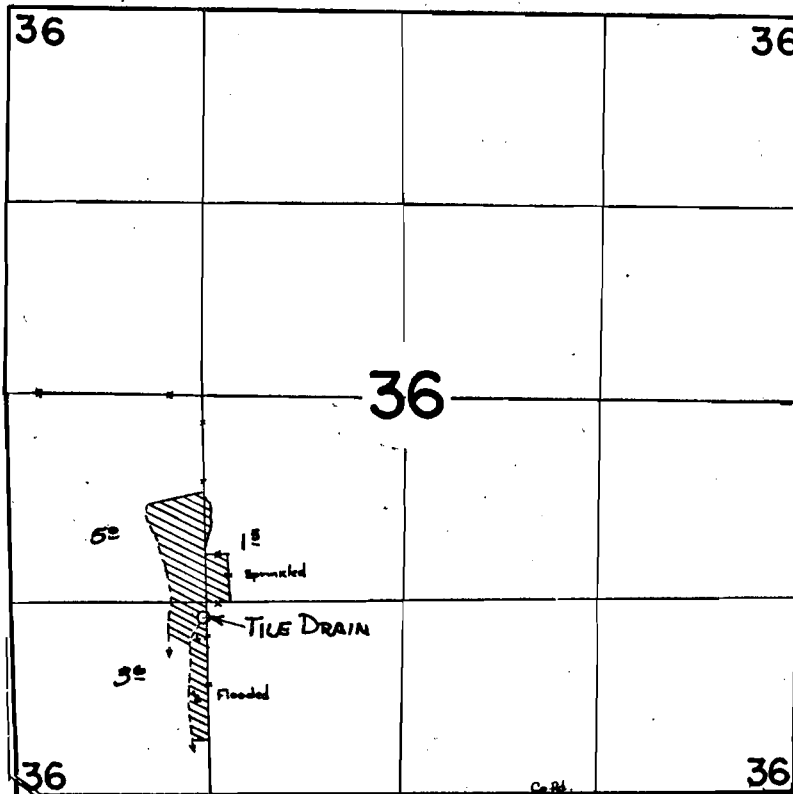

Well loc. 110' S. & 20' W. fr. N.E. Cor. SW<sup>1</sup>/<sub>4</sub>SW<sup>1</sup>/<sub>4</sub> Sec. 36.

## FINAL PROOF SURVEY

UNDER

Application No. G 2979 Permit No. G 2766

IN NAME OF

MRS. LOUISE SLY

Surveyed 17 JULY 1970, by D. R. BUELL