


T. 9 S. R. 40 E. W. M.

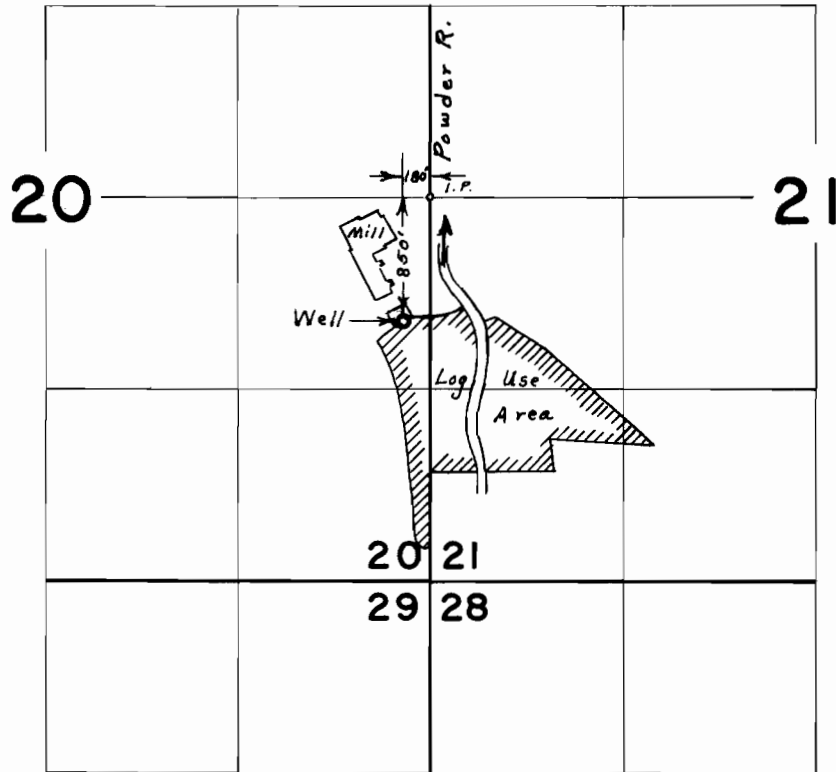

FINAL PROOF SURVEY UNDER

Application No. G-3374 Permit No. G-3009
IN NAME OF

ELLINGSON TIMBER CO., PLYWOOD DIV.

Surveyed Aug. 7, 1970, by L. E. Gould