


T. 8 S. R. 3 9 E. W. M.

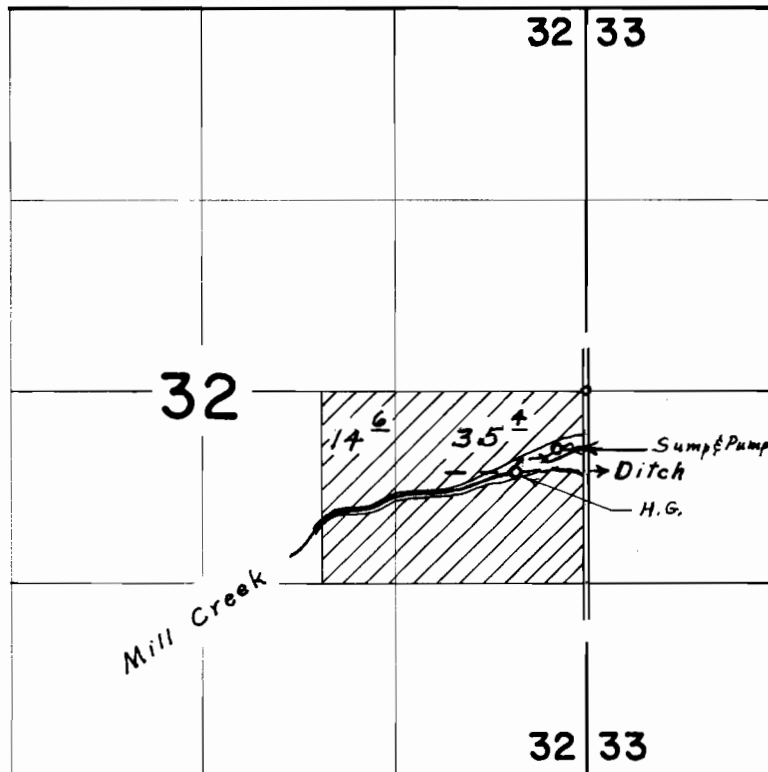

Sump located 420' S. & 180' W. from E. $\frac{1}{4}$ Cor. Sec. 32

FINAL PROOF SURVEY
UNDER

Application No. G-3307 Permit No. G-3080
IN NAME OF

CHARLES D. SIMPSON

Surveyed July 9, 1970, by L. E. Gould