


T. 8 S. R. 40 E. W.M.

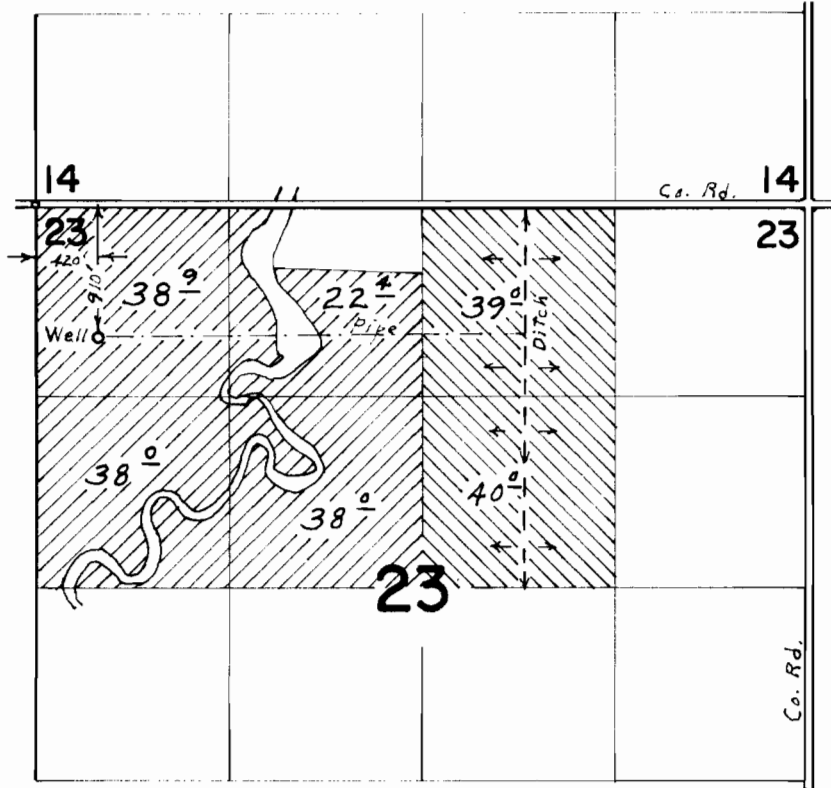

Primary 
 Supplemental 


FINAL PROOF OF SURVEY

Approved by G-3662 G-3438

GLEN E. TRUE

July 18, 70 L. E. Gould

T. 8 S. R. 40 E. W.M.

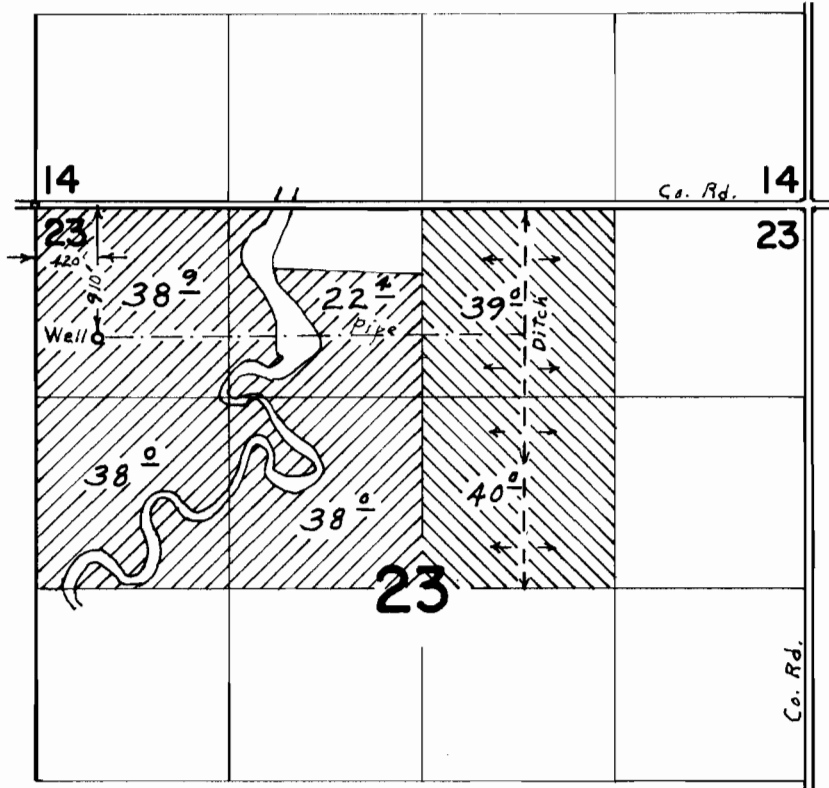

Primary 
 Supplemental 

FINAL PROOF SURVEY

UNDER

Application No. G-3662 Permit No. G-3438

IN NAME OF

GLEN E. TRUE

Surveyed July 18, 1970 by L. E. Gould