


**T. 6 S. R. 4 4 E. W. M.**

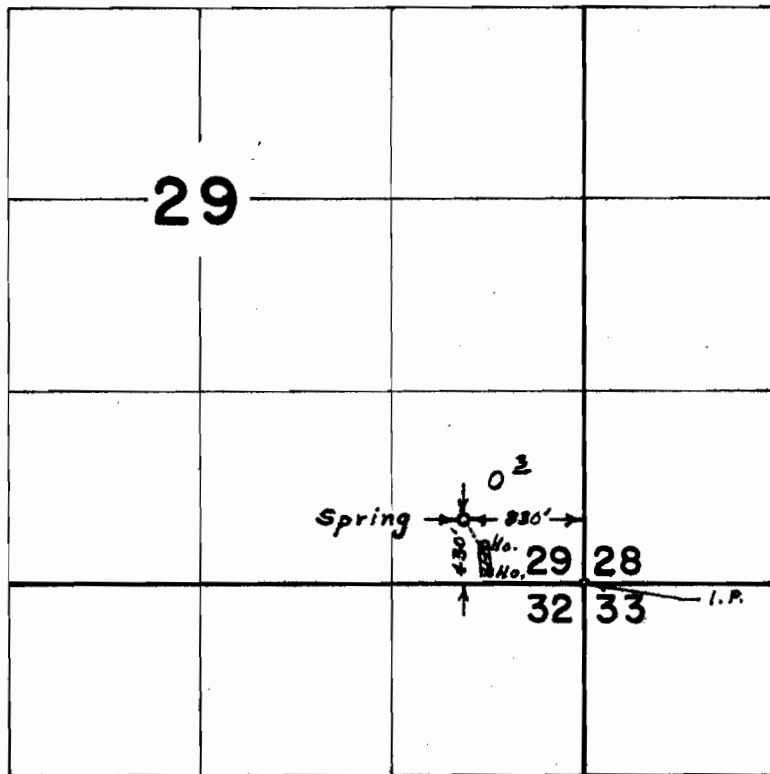

# FINAL PROOF SURVEY

UNDER

Application No. 40387 Permit No. 30108

IN NAME OF

ELI STANCIU & VELMA ALLEN

Surveyed Aug. 11, 1970, by L. E. Gould.