


T. 7 S. R. 38 E. W. M.

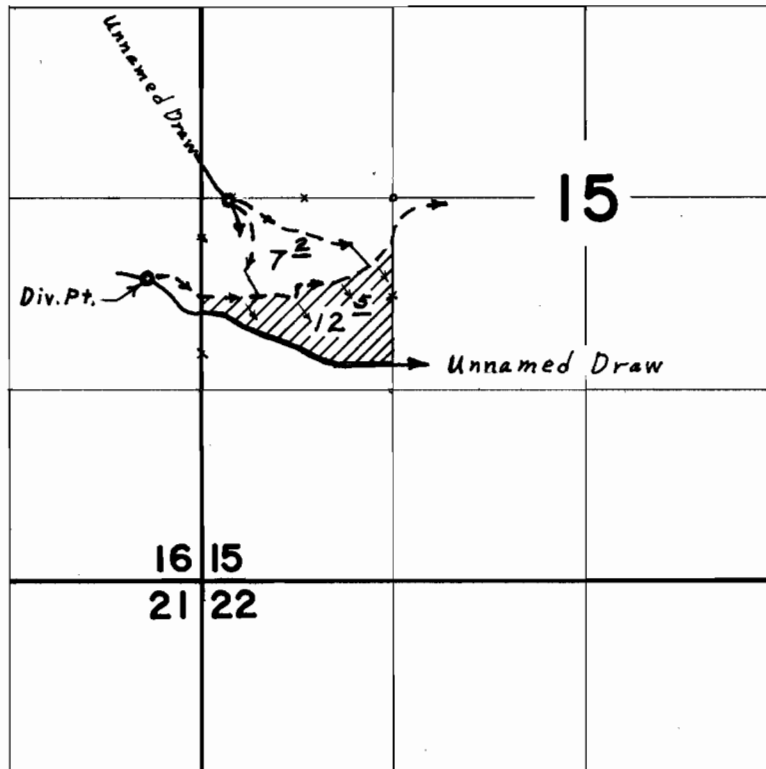

Div. Pt. located 550' S. & 1680' W. from N.E. Cor. N.W. & S.W. Sec. 15

FINAL PROOF SURVEY

UNDER

Application No. 40440 Permit No. 30146

IN NAME OF

KENNETH BOYER

Surveyed May 21, 1970, by L. E. Gould