


T. 13 S. R. 5 W. W. M.

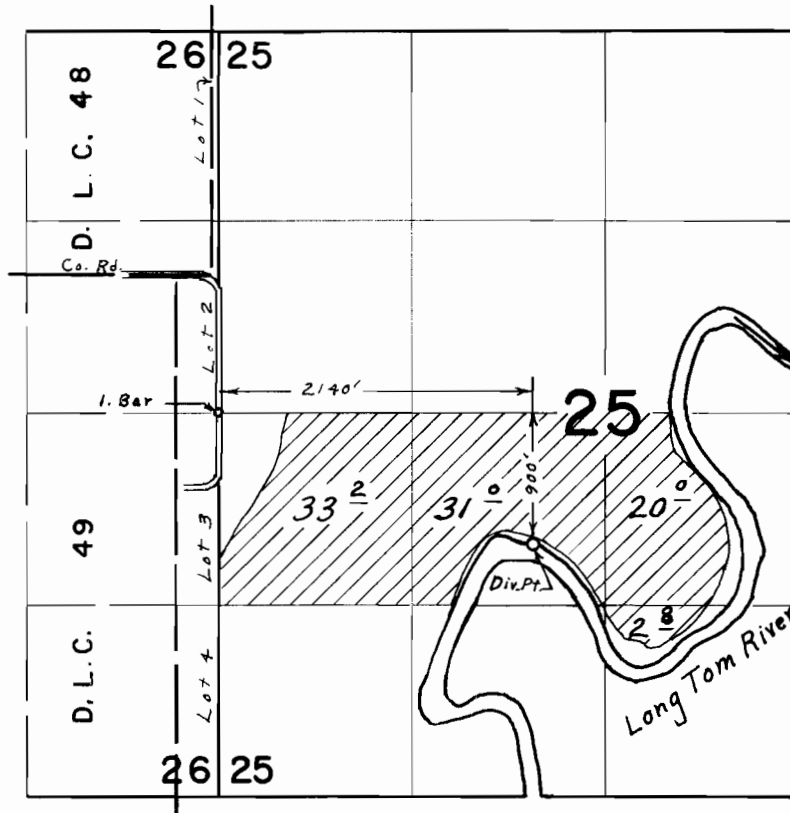

FINAL PROOF SURVEY UNDER

Application No. 42521 Permit No. 31776
IN NAME OF

HERMAN & LINNIE LINDSETH

Surveyed Sept. 3, 1970, by L. E. Gould