


T.14S.R.6W.W.M.

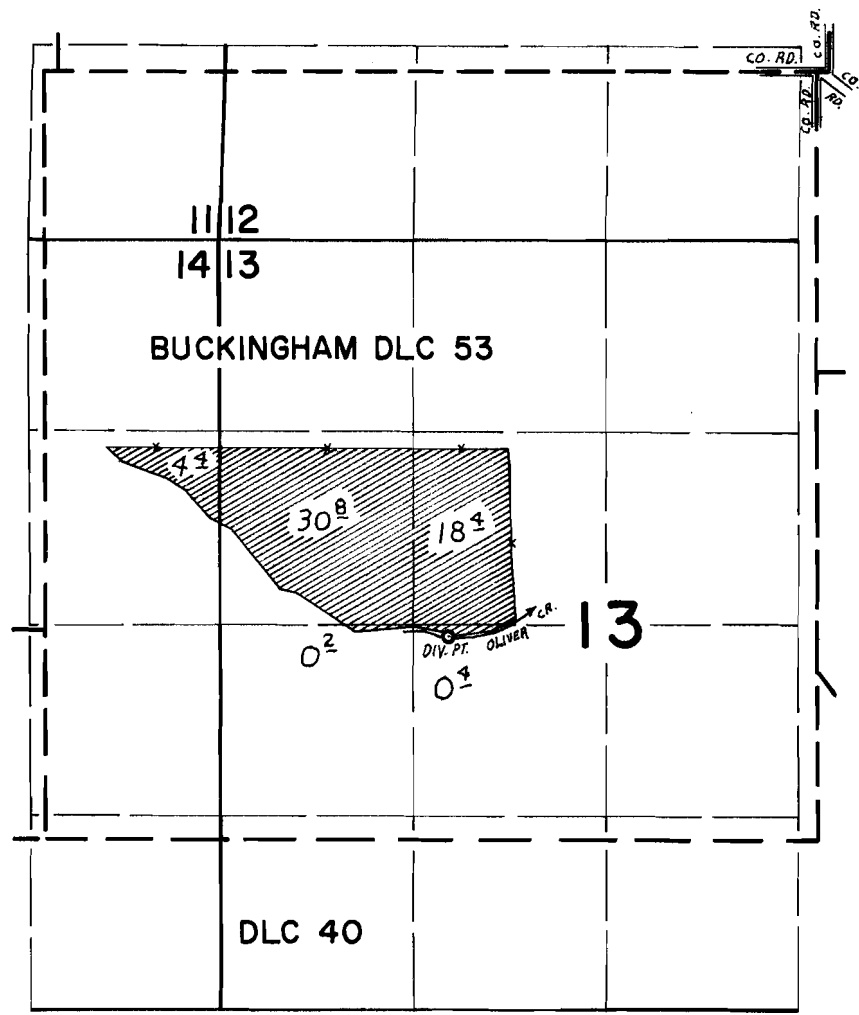

DIV. PT. LOC. 3870'S. & 2530' W. FROM BUCKINGHAM DLC 53



43605 32485

AMOS WEST

SEPT. 8 70 L.E. GOULD

T.14S.R.6W.W.M.

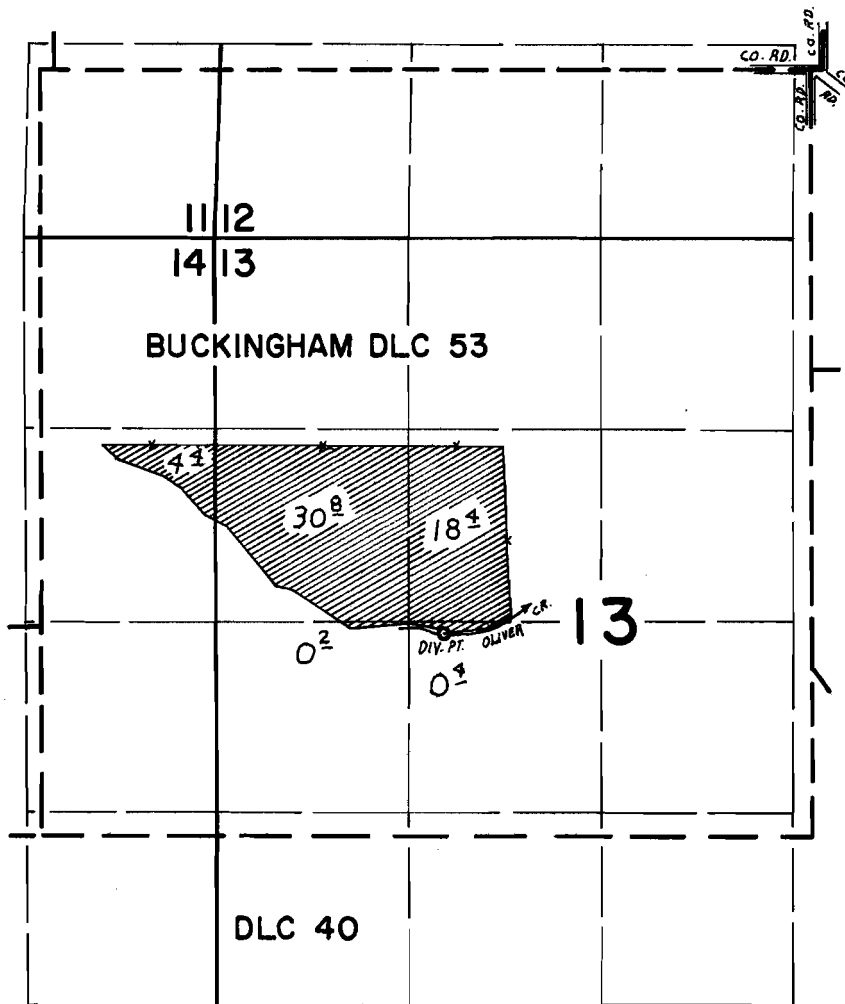

DIV. PT. LOC. 3370'S. & 2530' W. FROM BUCKINGHAM DLC 53

FINAL PROOF SURVEY

UNDER

Application No. 43605 Permit No. 32485

IN NAME OF

AMOS WEST

Surveyed SEPT. 8 19 70 by L.E. GOULD