


T. 15 S. R. 9 W. W. M.

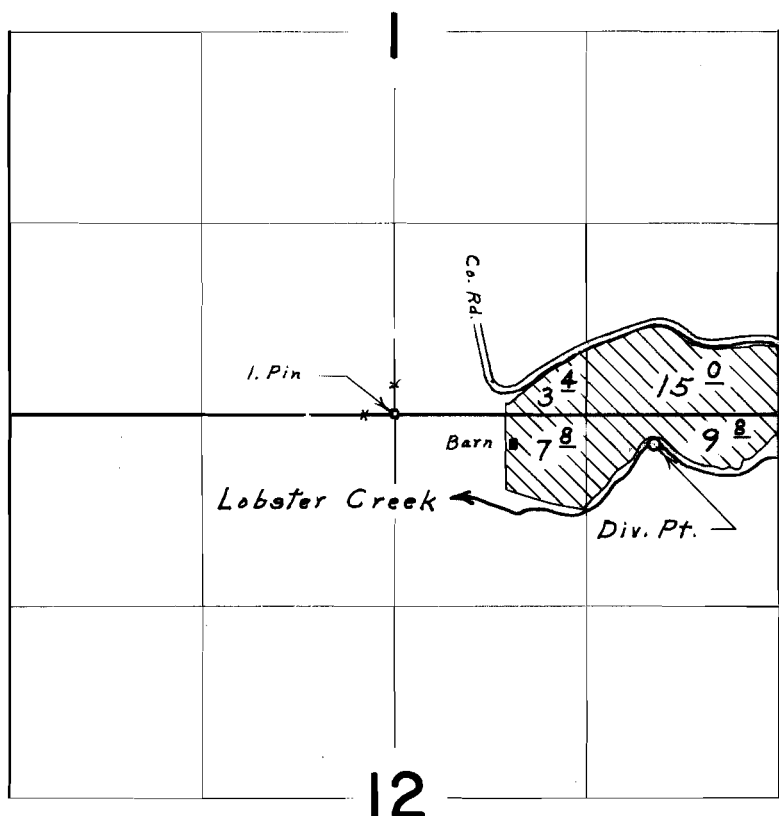

Div. Pt. located 200' S. & 1780' E. from S. 1/4 Cor. Sec. 1

FINAL PROOF SURVEY UNDER

Application No. 43684 Permit No. 32652
IN NAME OF

CLAUDE A. HENDRIX

Surveyed Sept. 15, 1970, by L. E. Gould