


T. 14 S. R. 8 W. W. M.

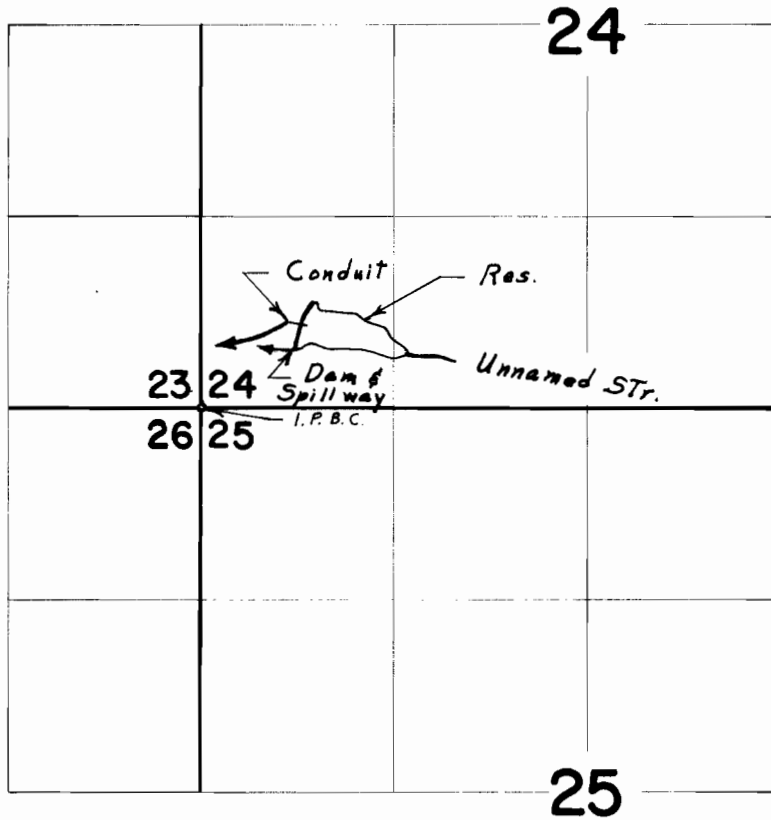

Div. Pt. located 580' N. & 680' E. From S.W. Cor. Sec. 24

FINAL PROOF SURVEY
UNDER

R-43687 R-5252
Application No. 44034 Permit No. 33237
IN NAME OF

GYGI & ENGEL

Surveyed Sept. 11, 1970, by L. E. Gould