


T.4S.R.2E.W.M.

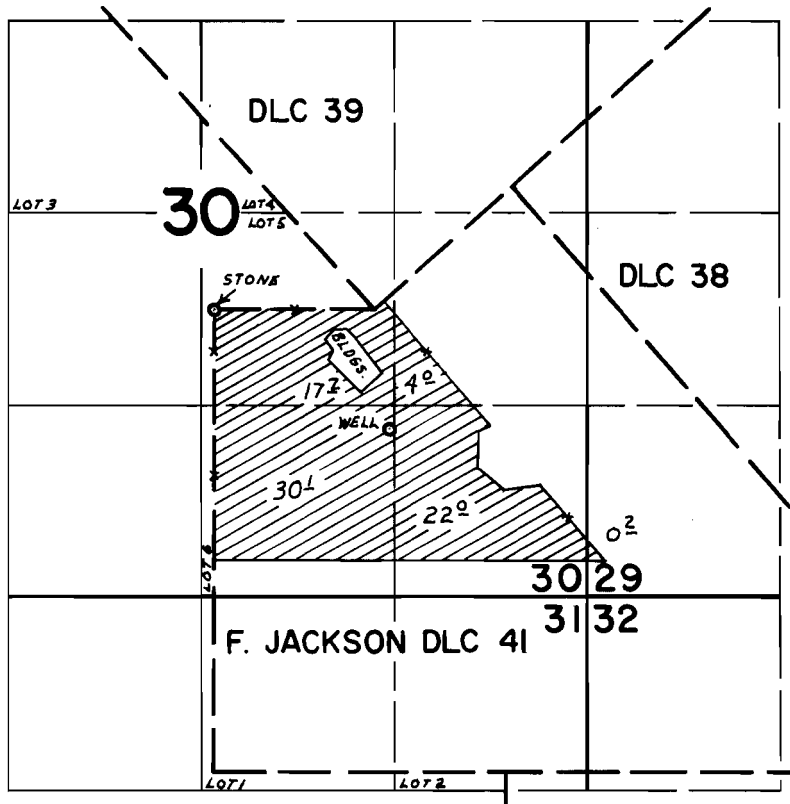

WELL LOC. B20'S. & 1200'E. FROM NW COR. F. JACKSON DLC 41

FINAL PROOF SURVEY UNDER

Application No. G-3248 Permit No. G-3049
IN NAME OF

V.R. STEINHAUSER

Surveyed SEPT. 23 1970, by L.E. GOULD