


T. 4 & 5 S. R. 3 E. W. M.

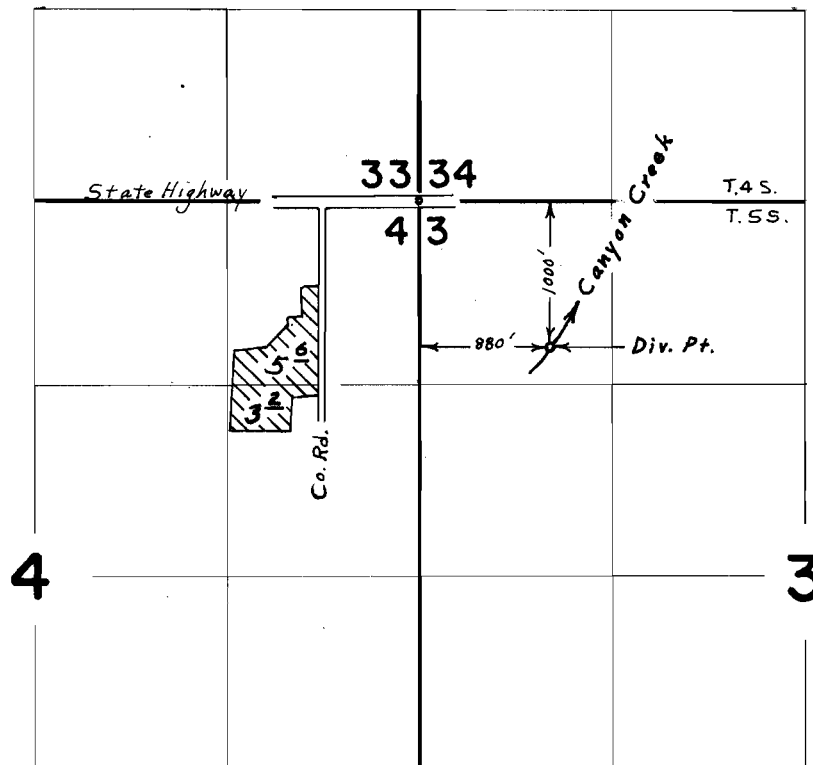

FINAL PROOF SURVEY

UNDER

Application No. 42205 Permit No. 31570

IN NAME OF

COLTON PUBLIC SCHOOL DIST. 53

Surveyed May, 4, 1970, by L. E. Gould