


T.4S.R.2E.W.M.

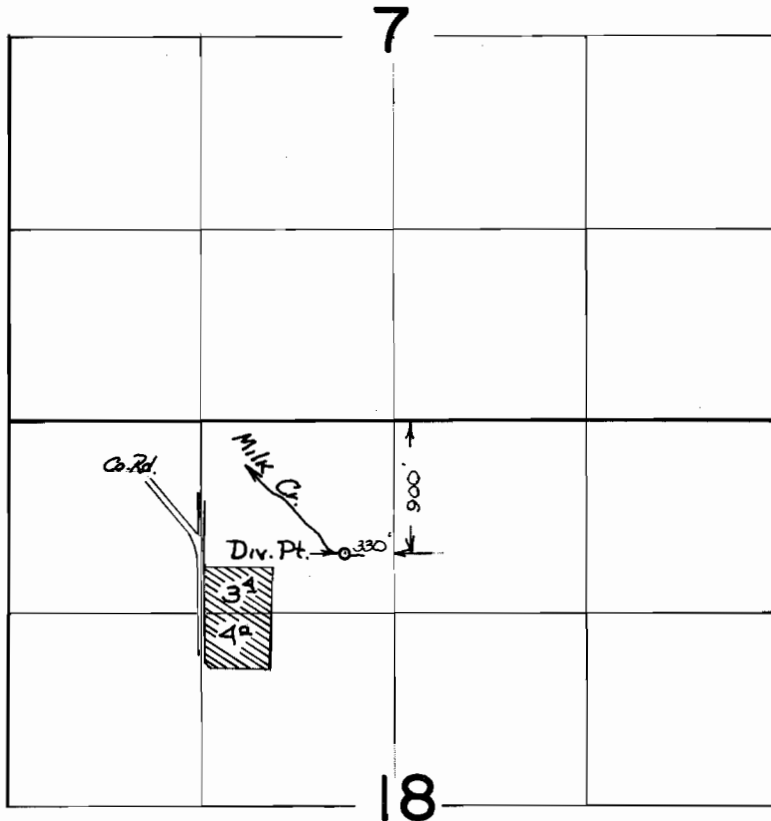

FINAL PROOF SURVEY
UNDER

Application No. 44452 Permit No. 33248
IN NAME OF

OSCAR ALBER

Surveyed 16 SEPT. 1970, by L. E. GOULD