


T.31S. R.18&2W. W.M.

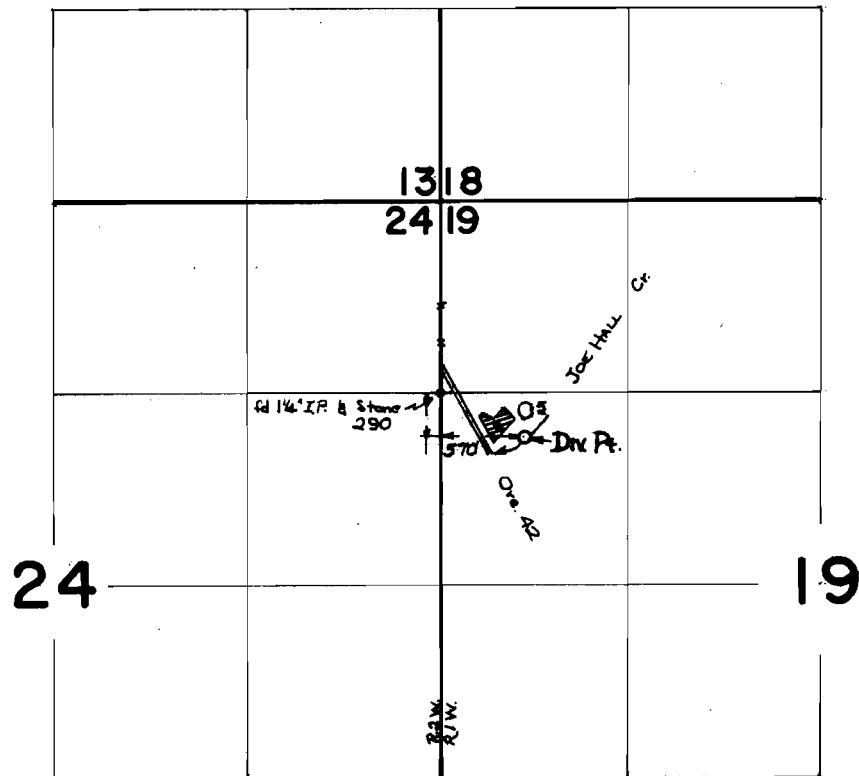

FINAL PROOF SURVEY

UNDER

Application No. 4413 Permit No. 30934

IN NAME OF

GLANN C. ROGERS

Surveyed 3 JUNE 1970, by D.R. BUELL