


# T.28 & 29 S. R.4 W.W.M.

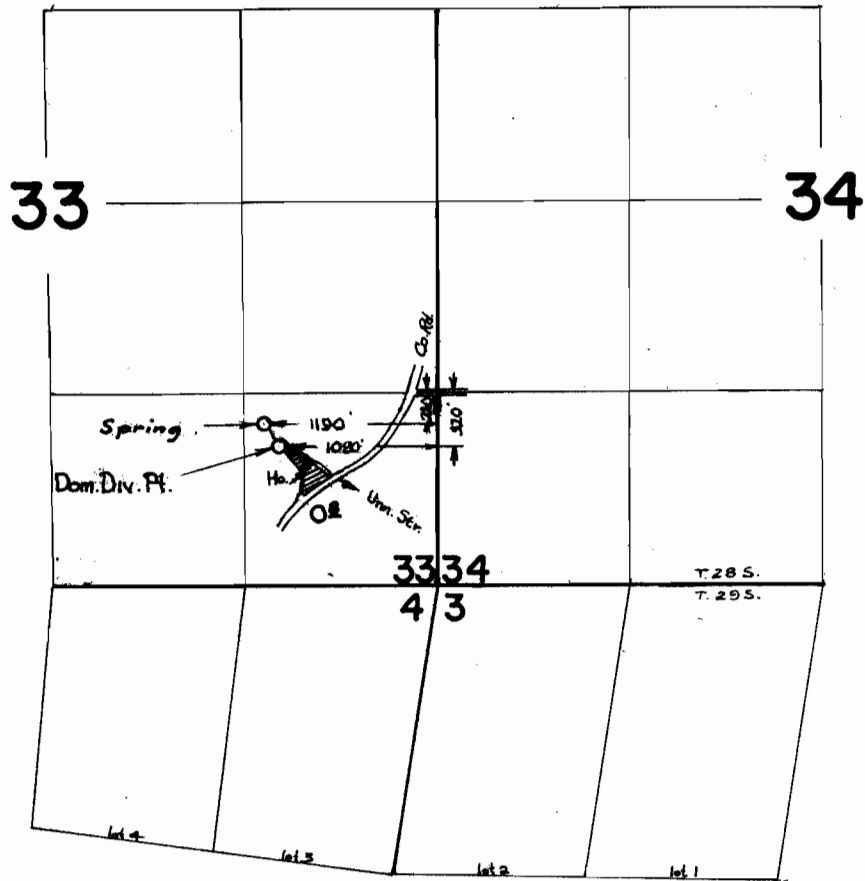

## FINAL PROOF SURVEY

UNDER

Application No. 42305 Permit No. 31635

IN NAME OF

ALBERT L. & MARY L. SOTERION

Surveyed 12 JUNE 19 70, by D. R. BUELL