


# T.21S.R.5W.W.M.

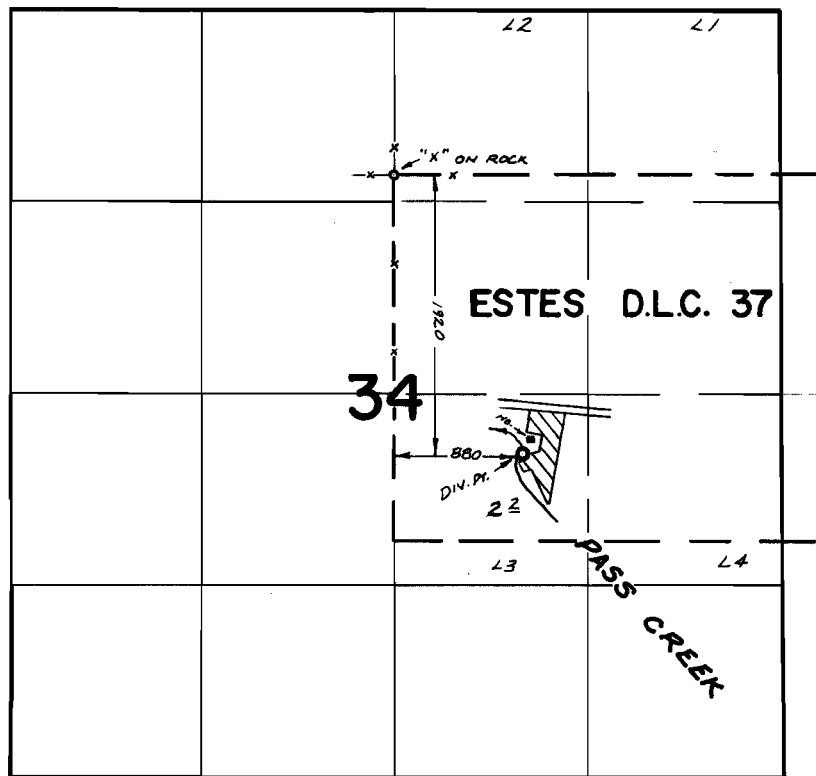

## FINAL PROOF SURVEY UNDER

Application No. 42324 Permit No. 3/643  
IN NAME OF

**ROY T. & LYDIA B. ANDERSON**

Surveyed JUNE 9, 1970, by R. MUCKEN