



T.29S. R.3 W. W.M.

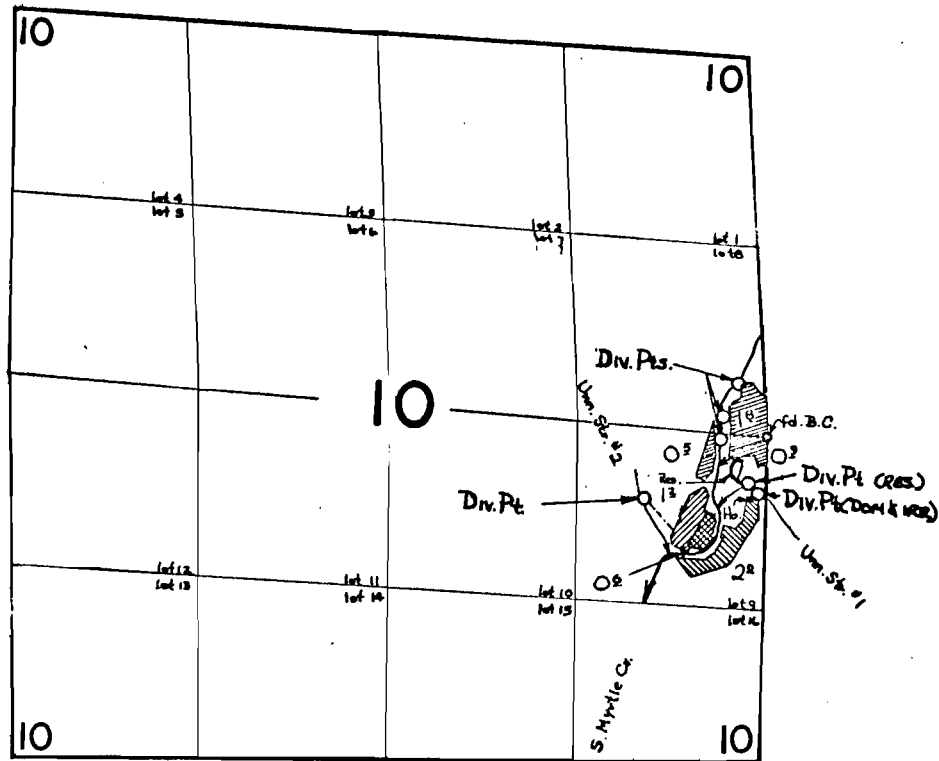

Div. Pts. loc: S. Myrtle Cr. 370' N & 190' W; 140' N & 290' W; 20' S & 320' W;
 Unn. Str. #1 320' S & 130' W; 390' S & 70' W; Unn. Str. #2 420' S & 830' W. all from
 E. 74 Cor. Sec. 10.

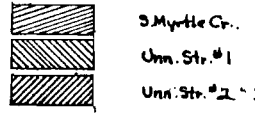

FINAL PROOF SURVEY

UNDER

Application No. R44011 42488 Permit No. R 5010 32577

IN NAME OF

VERDAN V. & VIVIAN JUNE MOORE

Surveyed 10 JUNE 1970, by D. R. BUELL