


T.27S.R.6W.W.M.

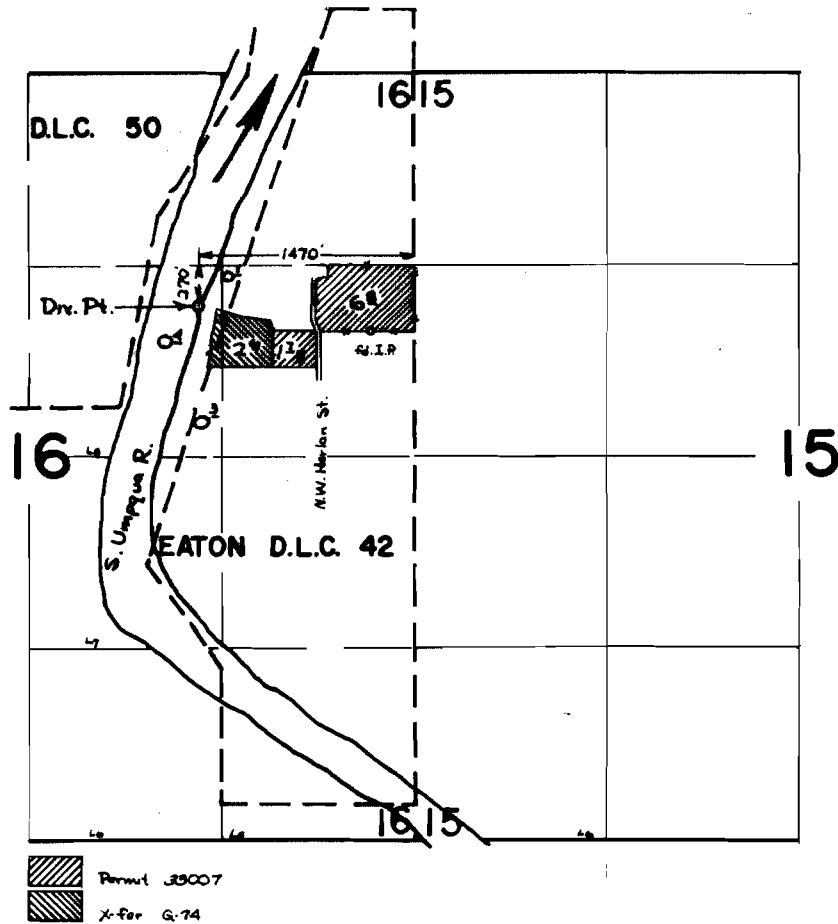

FINAL PROOF SURVEY UNDER

Application No. 44117 TRANSFER G 74
Permit No. 33007
IN NAME OF

TOMMY A. GREGG

Surveyed 27 AUG 1970, by D.R. BUELL