


T.I.S.R.2I.E.W.M.

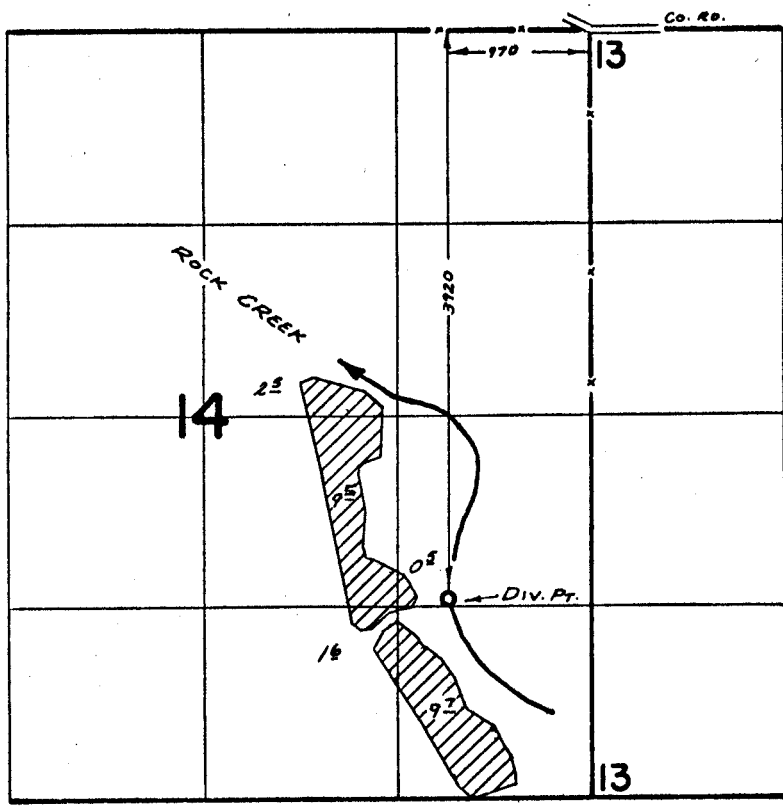

FINAL PROOF SURVEY

UNDER

Application No. 43260 ... Permit No. 32337

IN NAME OF

FLOYD PALMER

Surveyed Oct. 26 1970, by R. MUCKEN