


# T. 35 S. R. 6 W. W. M.

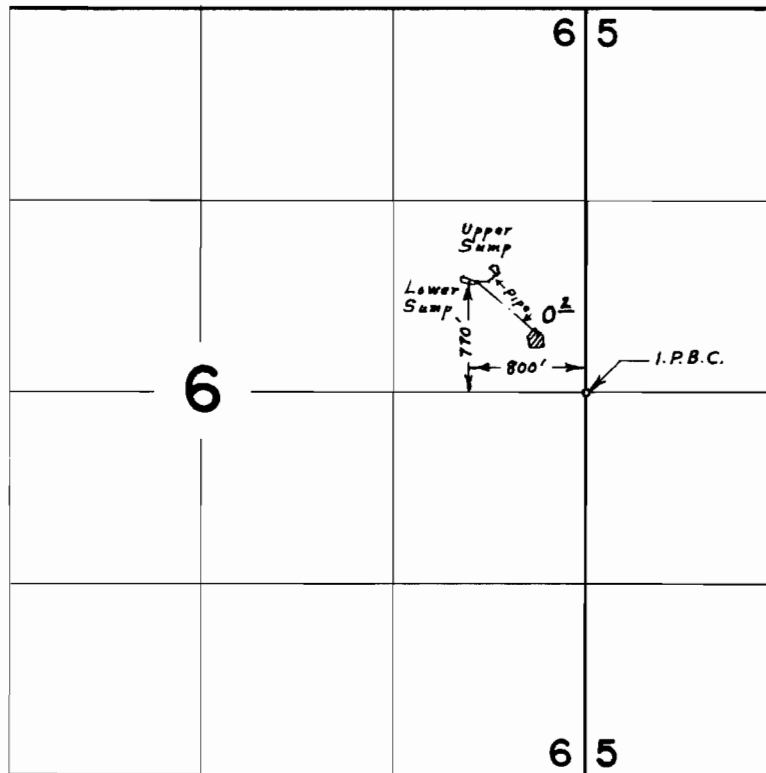

## FINAL PROOF SURVEY UNDER

Application No. G-2705... Permit No. G-2513...  
IN NAME OF

**GERALD W. & GERALD L. KINNEY**

Surveyed April 15, 1970, by L. E. Gould.