T. 34 & 35 S. R. 6 W. W. M.

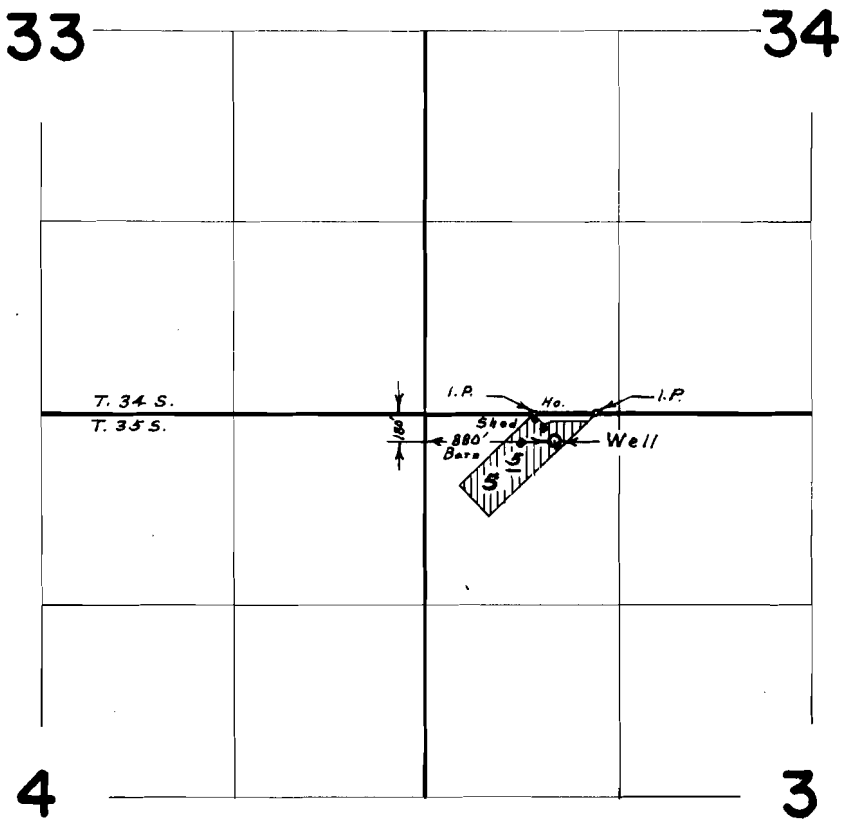

FINAL PROOF SURVEY

UNDER

Application No. G-2986 Permit No. G-2769

IN NAME OF

MARSHALL H. HALSTEAD

Surveyed April 14, 1970, by L. E. Gould

1970-S