


T. 38 & 39 S. R. 5 W. W.M.

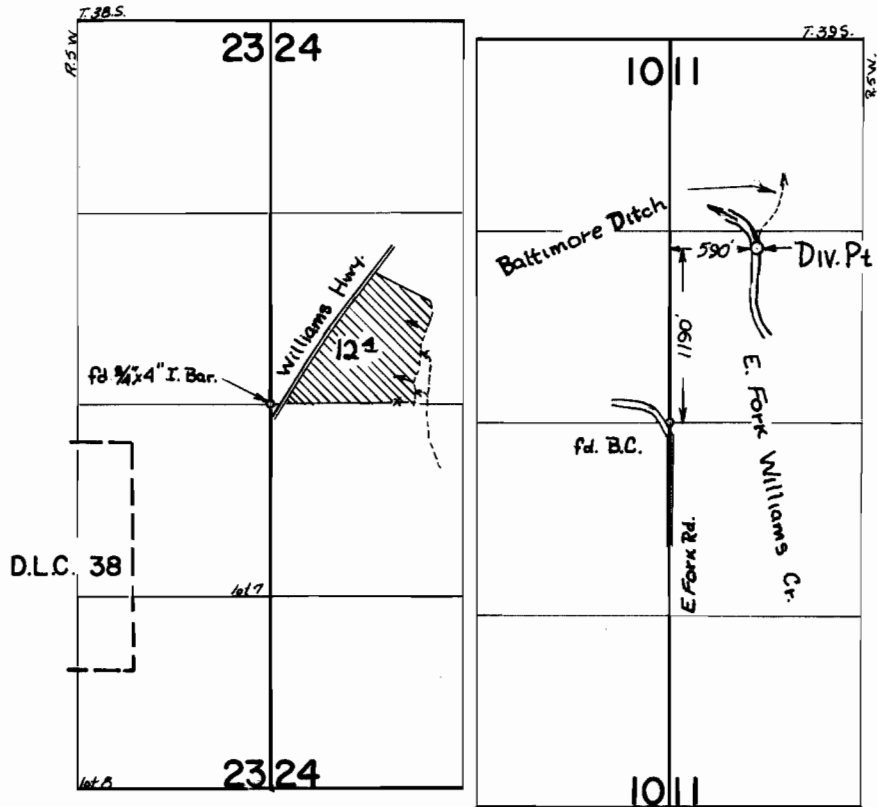

FINAL PROOF SURVEY UNDER

Application No. 38620 Permit No. 28928
IN NAME OF

GLEN ORVAL LEWMAN

Surveyed 1 MAY 1970, by D.R. BUELL