


T. 35 S. R. 7 W. W. M.

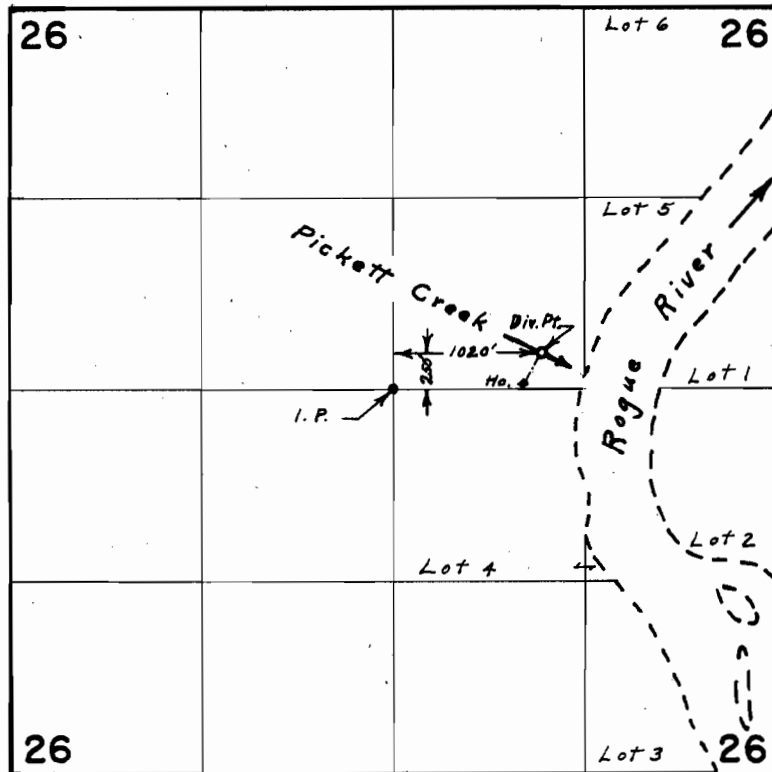

FINAL PROOF SURVEY

UNDER

Application No. ~~44283~~ Permit No. 33076

IN NAME OF

MARVIN N. FLORENCE

Surveyed April 17, 1970, by L. E. Gould