


T. 35 S. R. 7 W. W. M.

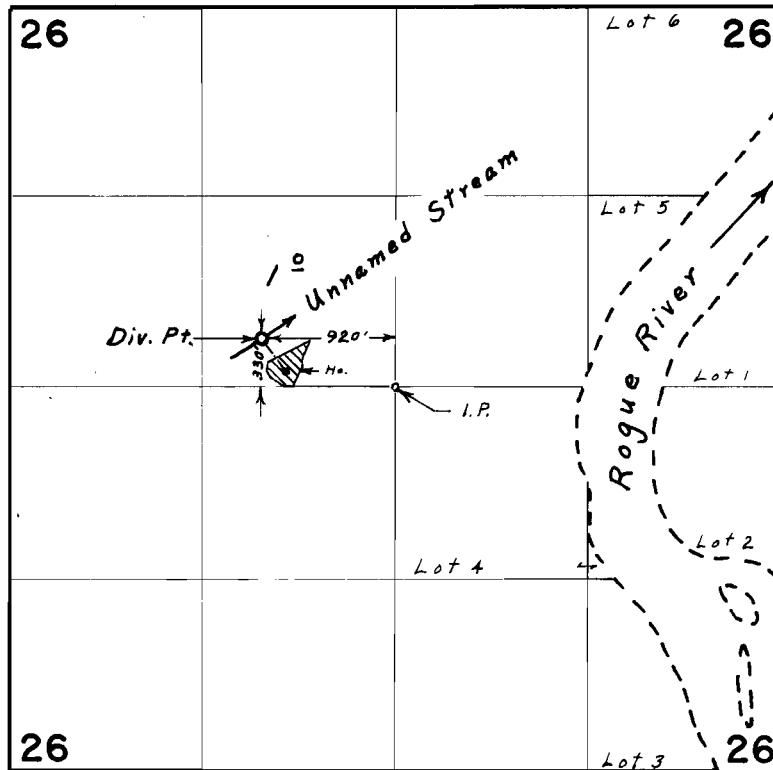

FINAL PROOF SURVEY

UNDER

Application No. 45165 Permit No. 33744

IN NAME OF

EDW. R. PALMER

Surveyed April 17, 1970, by L. E. Gould