


G-2684
37821

T.41S.R.10E.W.M.

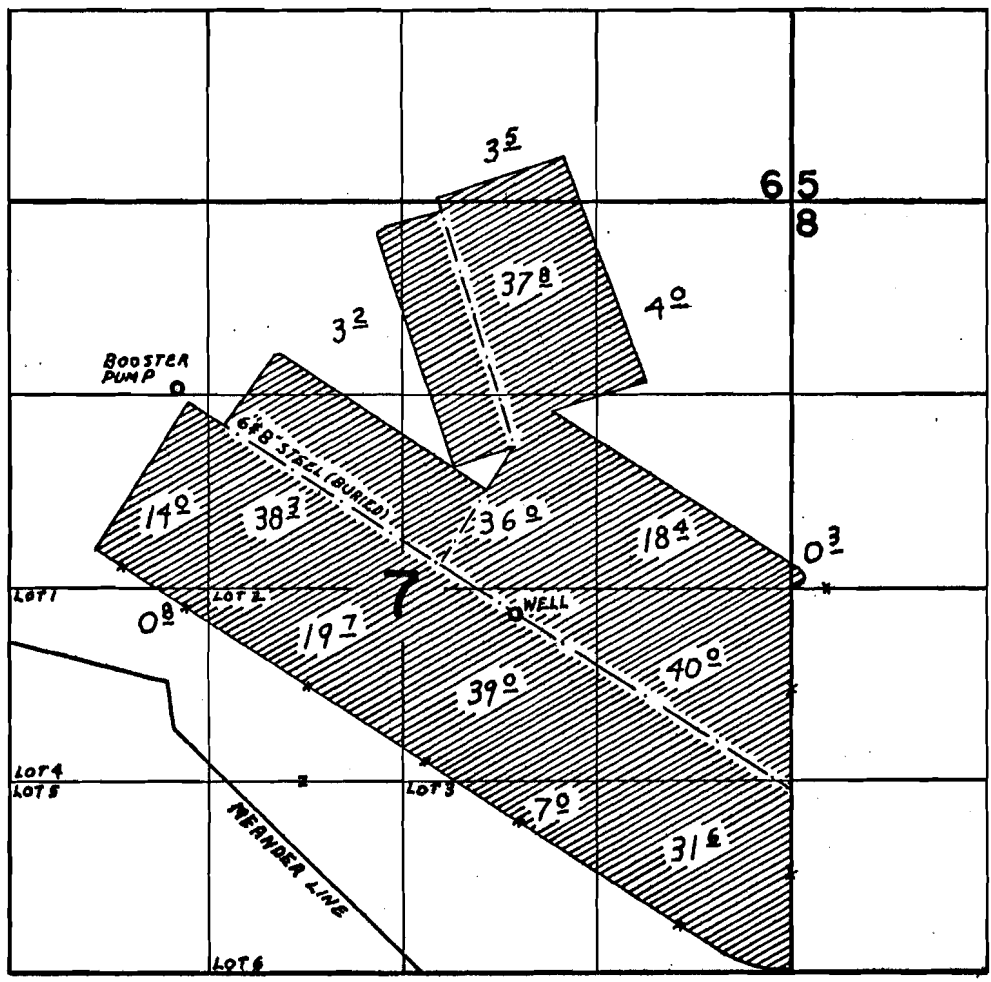

WELL LOC. 160'S. & 1870'W. FROM E. 1/4 COR. SEC. 7

Just W. wells

FINAL PROOF SURVEY

UNDER

Application No. G-2902 Permit No. G-2684

IN NAME OF

O'CONNOR LIVESTOCK COMPANY

Surveyed OCT. 27, 19 70, by G. BACA