


G-2996
37823

T.38&39S.R.II/2E.W.M.

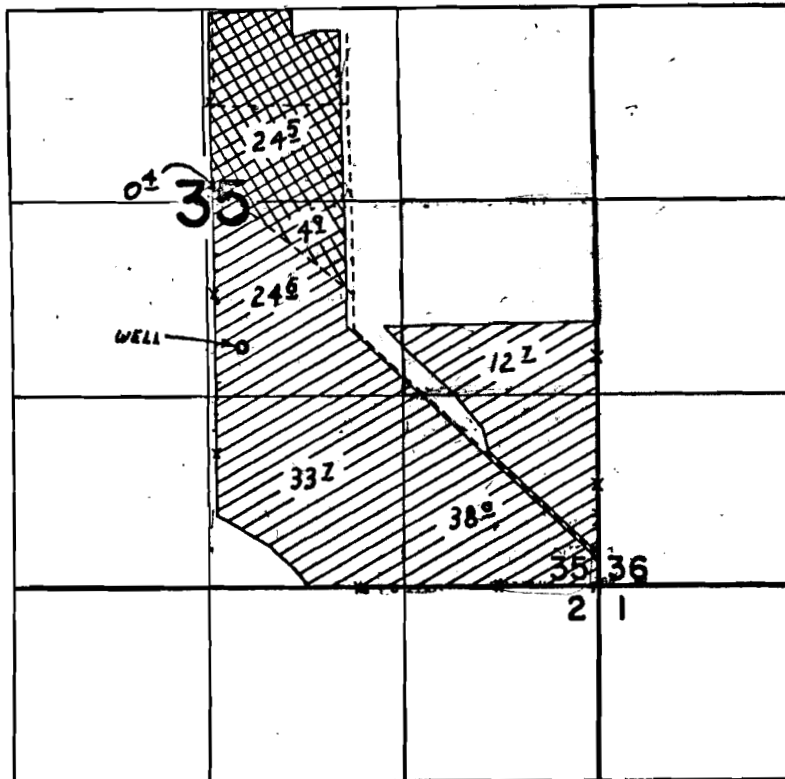

WELL LOC. 1650' N & 2420' W FROM SE COR. SEC. 35

 PERMIT NO. G-3670
 PERMIT NO. G-2996

FINAL PROOF SURVEY

UNDER

Application No. G-3193 Permit No. G-2996

IN NAME OF

ROBERT V. WALKER

Surveyed: SEPT. 17, 1970, by G. BACA

Just finer wells