


G-4125  
37824

# T.40S.R.12E.W.M.

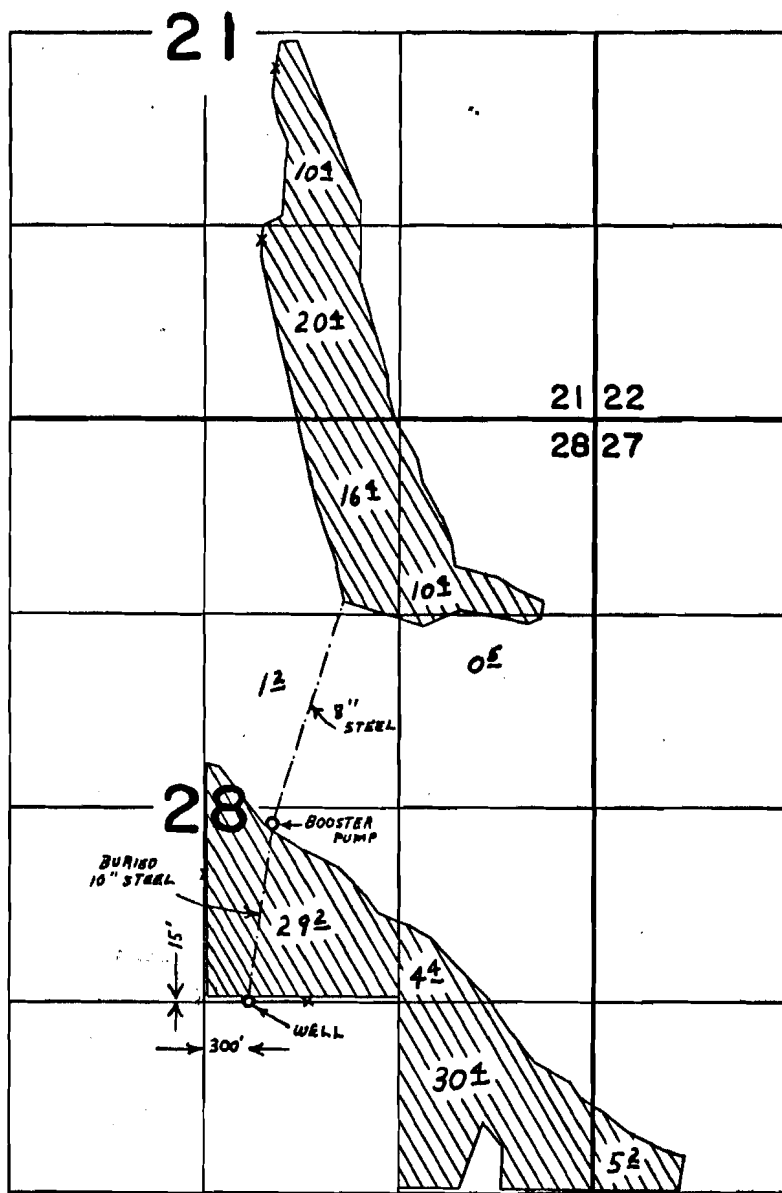

Just Po. wells

## FINAL PROOF SURVEY UNDER

Application No. G-4373 Permit No. G-4125  
IN NAME OF

ALBERT LeQUIEU

Surveyed SEPT. 21, 1970, by G. BACA