


27711
37825 14

T.40S.R.6.E.W.M.

Klamath R. mead.

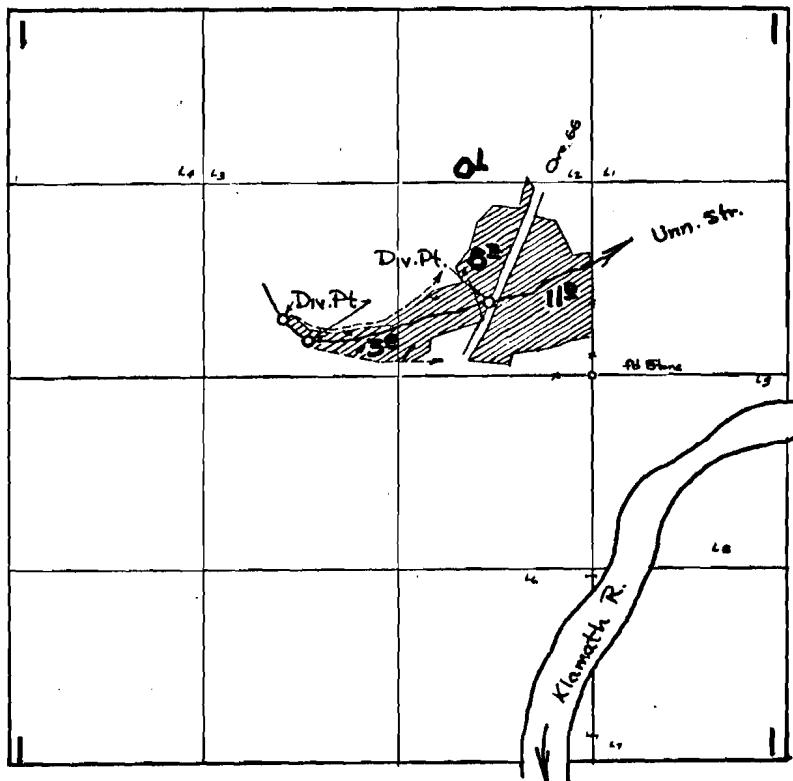

Div. Pt. loc.: 400' N & 2090' W; 240' N & 1930' W; 500' N & 690' W all from SE. Cor. SW 1/4 Sec. 1.

FINAL PROOF SURVEY UNDER

Application No. 37151 Permit No. 27711
IN NAME OF

R. B. CASWELL & L. L. SIMMON

Surveyed 12 AUG 1970, by D. R. BUELL