


29507
37826

T.32 & 33 S. R. 7 1/2 W. W.M.

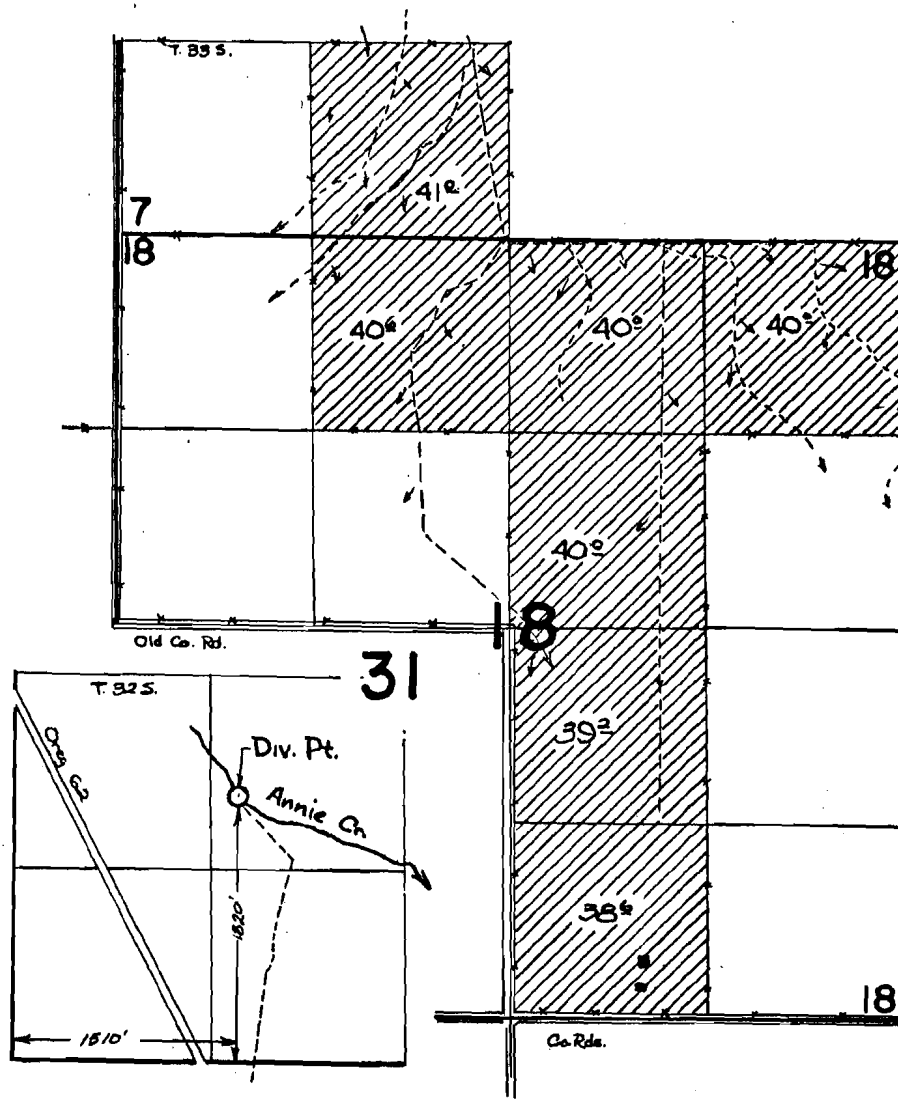

FINAL PROOF SURVEY

UNDER

Application No. 39049 Permit No. 29507

IN NAME OF

ELMORE E. NICHOLSON

Surveyed 16 MAY 1970, by D. R. BUELL