
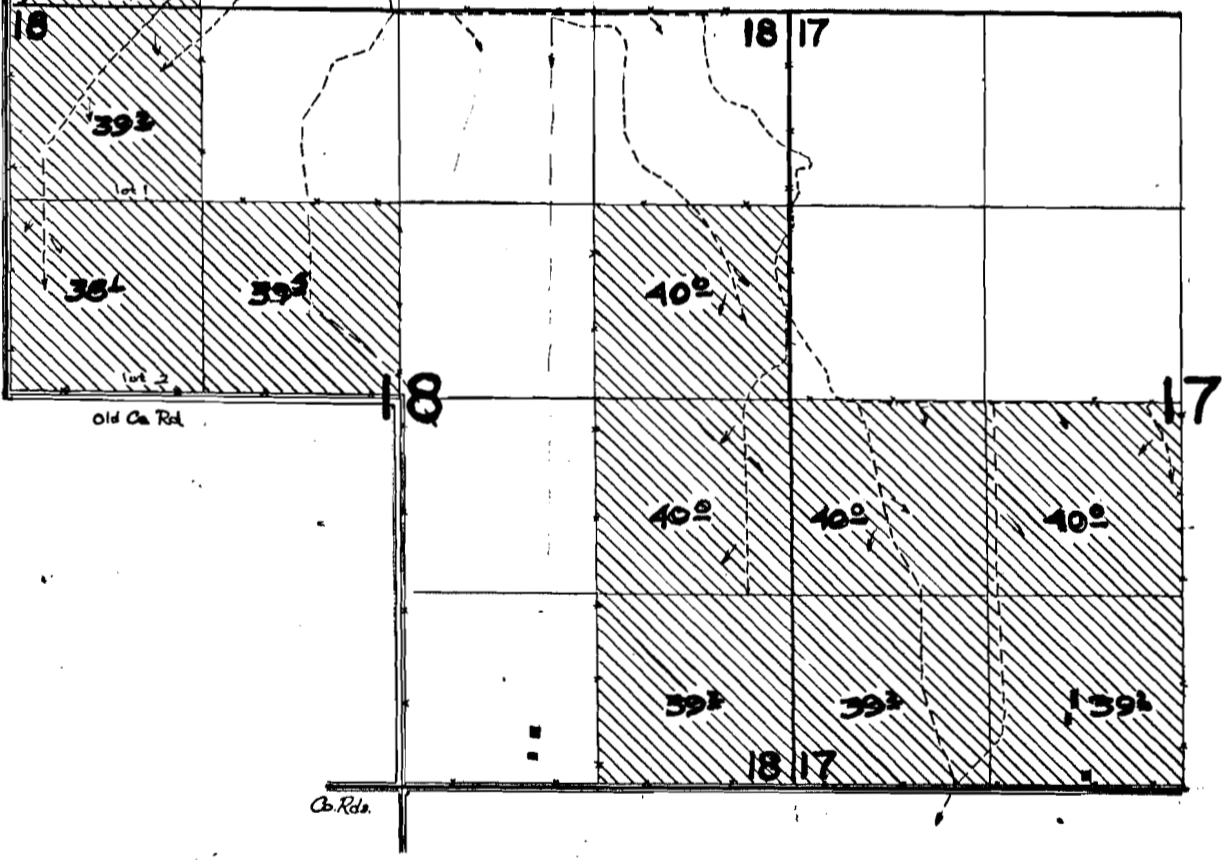
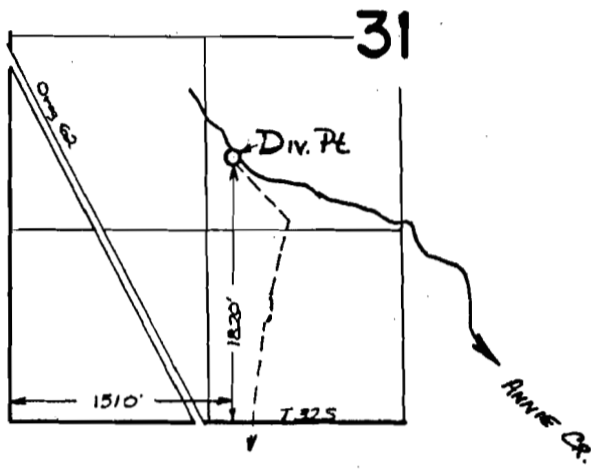


37827
14

T.32 & 33 S. R.7 1/2 E. W.M.

29531

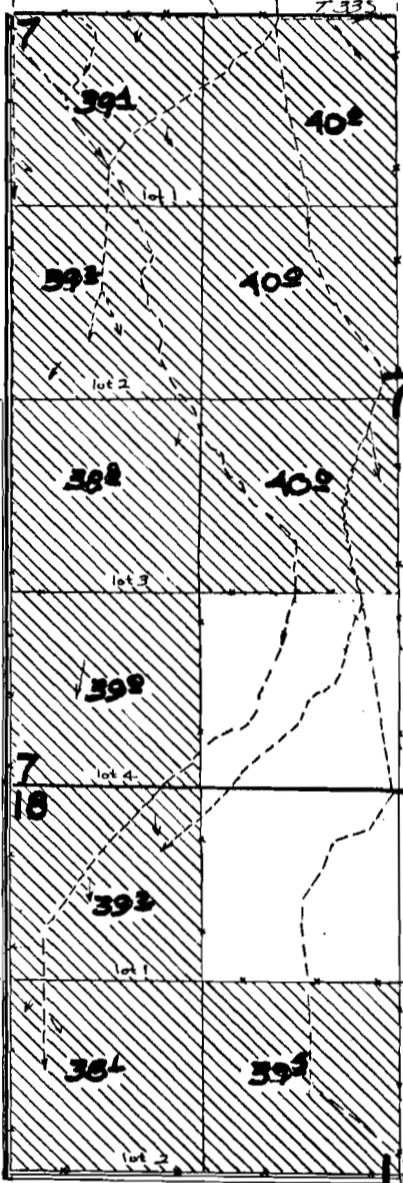

FINAL PROOF SURVEY

UNDER

Application No. 39670 Permit No. 29531

IN NAME OF

STEWART E. NICHOLSON

Surveyed 16 MAY 1970, by D.R. BUELL