


30088
37828

T.33 S. R.7 1/2 E. W.M.

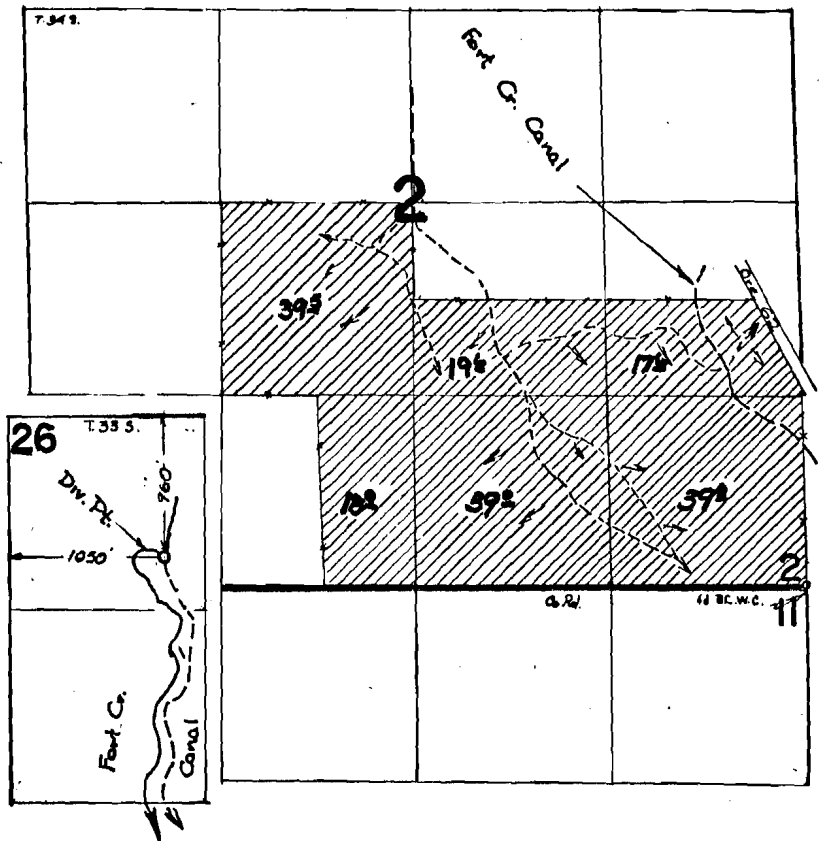

Crooked Creek & Misc.

FINAL PROOF SURVEY UNDER

Application No. 40355 Permit No. 30088
IN NAME OF

BETSY EFFMAN

Surveyed 22 MAY 1970, by D.R. BUELL