


14

N. 1/4 Sprague Av. & Misc.  
T.36S.R.14E.W.M.

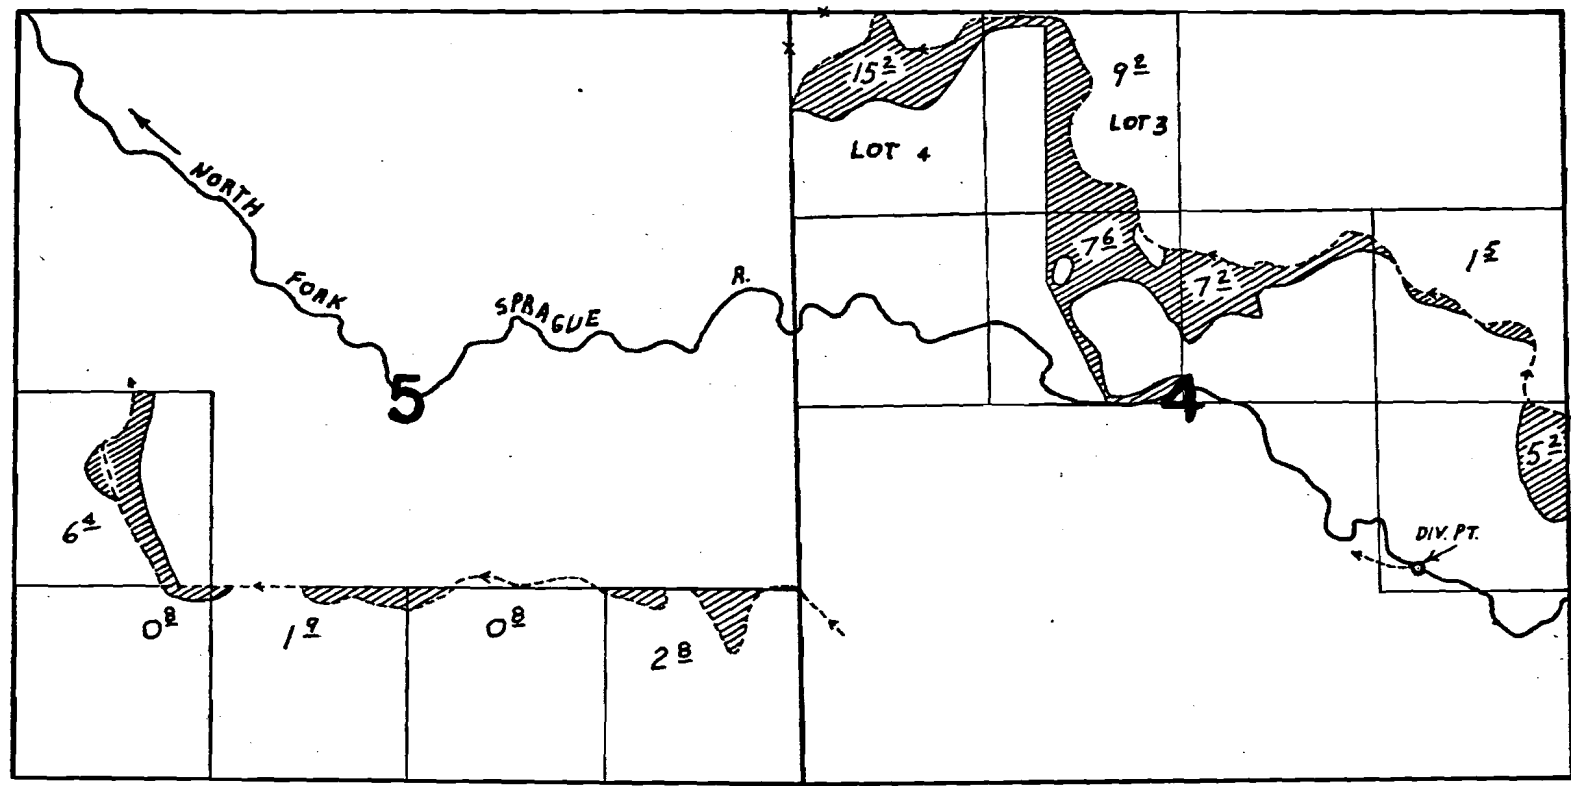

DIV. PTS. LOC: 3790'S. & 7720'E.; 3840'S. & 4230'E.; BOTH FROM NW COR. SEC. 4

# FINAL PROOF SURVEY


UNDER

Application No. 10651 Permit No. 30283

IN NAME OF

**YAMSAI LAND and CATTLE COMPANY**

Surveyed OCT. 20. 19. 70., by G. BACA

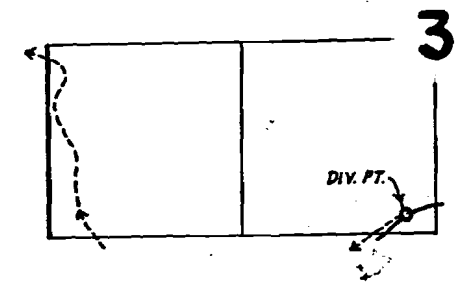

30283  
37829